

Scott
F 2000

MISSISSIPPI
BOARD OF WATER COMMISSIONERS
416 North State Street
Jackson, Mississippi 39201

WATER WELL DRILLERS LOG

7/15 1986 R. R. Wilkerson SCOTT
date well completed firm name county well located

LANDOWNER: W/L WATKINS
W/L WATKINS
Greent Miss
(mailing address)

WELL LOCATION:
sec. 34 T 7 N R 7 E W
8 miles NW of GREENT
(distance) (direction) (nearest town)

WELL PURPOSE:
(home, irrigation, municipal, industrial)

WELL COMPLETION DATA:

(1) diameter (inches) 2"

(2) total depth (feet) 260'

(3) static water level (feet) 80' below top of ground.

(4) casing Sch 40, 250' (material) (depth)
if telescope see back.
(size)

(5) screen 10" 250' (length) (depth to top)
2" 5' (size) (material)

(6) pump 1/2 HP, 15 (HP) (yield gpm)
ELC (type power)

(7) electric log No (yes or no)
(organization running log)

(8) how well bottom plugged Valve

description of formations encountered	from	to
Yellow clay	0	10
Reddish clay	10	20
Yellow clay	20	30
Yellow clay	30	40
Yellow clay	40	50
Sandy clay	50	60
Sandy clay	60	70
Sandy clay	70	80
Sandy clay	80	90
Sandy clay	90	100
Sandy clay	100	110
Sandy clay	110	120
Reddish clay	120	130
Reddish clay	130	140
Reddish clay	140	150
Reddish clay	150	160
Reddish clay	160	170
Reddish clay	170	180
Brown clay	180	190
Brown clay	190	200
Brown clay	200	210
Brown sand clay	210	220
Sandy clay	220	230
SAND	230	240
SAND	240	250
SAND	250	260
SAND	260	270
SAND	270	280
CLAY	280	290
CLAY	290	300


RECEIVED
AUG 11 1986

DRILLERS REMARKS:
SAND CONCRETE

MISSISSIPPI DEPARTMENT OF Natural Resources
BUREAU OF Land & Water Resources

If well telescopes please
sketch and show depths.

GROUND LEVEL

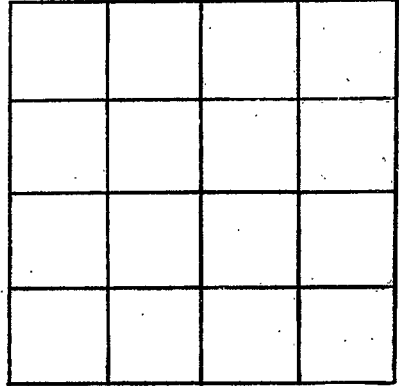

SECTION _____

Please indicate well location X.

ADDITIONAL INFORMATION

If more than one screen,
show locations of each on sketch.