

MISSISSIPPI DEPARTMENT OF NATURAL RESOURCES

Bureau of Land and Water Resources

P.O. Box 10631

Jackson, Mississippi 39209

WATER WELL DRILLERS LOG

COUNTY WELL LOCATED SCOTT	
WELL NUMBER F 2001	CODED
DATE WELL COMPLETED 10-4-88	

PERMIT NUMBER
NAME OF DRILLING FIRM GARDNER DRILLING
SEDASTOPEL, MS.

NAME & MAILING ADDRESS OF LANDOWNER LARRY M Knight			
RT. 5 Box 282			
FOREST, MS. 39874			
WELL LOCATION:	SEC	TOWNSHIP	RANGE
	36	7 N	7 E
DISTANCE	DIRECTION	NEAREST TOWN	
8 Miles	NW	of FOREST	
OTHER LANDMARK			
WELL PURPOSE: <input checked="" type="checkbox"/> Home, <input type="checkbox"/> Irrigation, <input type="checkbox"/> Municipal, <input type="checkbox"/> Industrial, <input type="checkbox"/> Fish Pond, etc.			

PUMP DATA		
PUMP TYPE (Circle One): Submersible, Turbine, Jet, Flowing Well, Other (Describe) <u>AIR COMP.</u>		
POWER TYPE (Circle One): <input checked="" type="checkbox"/> Electric, Tractor, Diesel, Gasoline, Butane, Other (Describe)		
Pump Capacity (GPM)	No. of Stages	Setting Depth
—	—	200 FT.
PUMP TEST		
Well yielded <u>12</u> GPM with a drawdown of <u>15</u> ft. after <u>2</u> hours of pumping		

WELL DATA		
Well Depth 295'	Casing Diameter (In.) 2	Casing Length (Ft.) 20
Type of Casing PVC	Hole Depth 295'	Depth to Static Water Level 78'
TYPE OF COMPLETION: (Circle One or More): <input checked="" type="checkbox"/> Gravel Packed, <input type="checkbox"/> Underreamed, <input type="checkbox"/> Telescoped, <input type="checkbox"/> Natural Development, <input type="checkbox"/> Open Hole, <input type="checkbox"/> Other		
Top of Lap Pipe or Reduction in Casing		
FEET	IF TELESCOPED OR MORE THAN ONE SCREEN: USE BACK PAGE	

LOG DATA	
TYPE OF LOG RUN (Circle One): No Log Run, Electric, Gamma Ray, Density, Sonic, Neutron, Other (Describe)	
Name of Organization-Running Log	

SCREEN DATA		
Diameter - Inches 2	Length - Feet 10	Slot Size - Inches 8
Screen Type PVC	Depth to Bottom - Feet 295	

GEOLOGIC DATA (Office Use Only)			
Surface Elev.	Geologic Unit	Unit Thickness	Depth to Top
Subs. SWL	Date	Analysis	Aquifer Test
Driller's Remarks			

DESCRIPTION OF FORMATIONS ENCOUNTERED	FROM	TO	FORMATIONS (continued)	
			FROM	TO
CLAY	0	30		
CLAY & SAND ledges	30	240		
SAND	240	295		

RECEIVED


FEB 10 1989

Department of Natural Resources
Bureau of Land & Water Resources

IF MORE SPACE IS NEEDED, USE BACK

If well telescopes please
sketch and show depths.

GROUND LEVEL

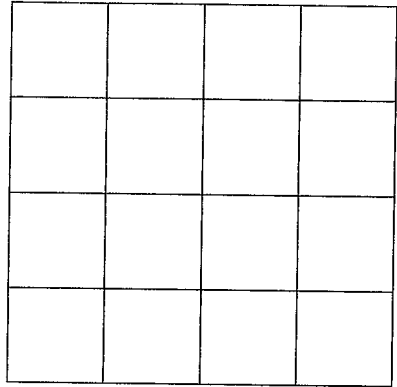

SECTION _____

Please indicate well location X.

ADDITIONAL INFORMATION

If more than one screen,
show location of each on sketch.