

SCOTT MISSISSIPPI BOARD OF WATER COMMISSIONERS

G 3

WATER WELL DRILLERS LOG

3 11-7-65

Date: 11/7, 1965, Driller: Forest Drilling County Scott
 (Name)


B.C. Rogers

(1) Owner of Land:	Description & Color of Materials Sand, Clay, Red Clay, Shell, etc.	Thick- ness Feet	Depth Feet
<u>Weldon Dope</u> (Name) <u>Rt 3 - Forest Miss</u> (Address)	<u>Brown Clay</u>		<u>24</u>
(2) Location: <u>SE 1/4, SW 1/4, Sec 16 T 7 N R 7 E</u>	<u>Blue Clay</u>		<u>42</u>
<u>3</u> miles <u>South</u> of <u>Hildsham</u> (distance) (direction) (Nearest Town)	<u>Clay + Lime Rock</u>		<u>52</u>
(3) Topography: <input checked="" type="checkbox"/> (Hilly) <input type="checkbox"/> (Flat) <input type="checkbox"/> (Level)	<u>Clay + Sandy Shell</u>		<u>67</u>
(4) Purpose of Well: <u>Home</u> (Domestic Irrigation Municipal, Industrial, Other)	<u>Clay</u>		<u>132</u>
	<u>Fine Sand + Clay</u>		<u>142</u>
	<u>Fine Sand</u>		<u>185</u>
	<u>Clay</u>		<u>242</u>
	<u>Clay + Gt Sh + Sand</u>		<u>272</u>
	<u>Fine Sand + 10% Clay</u>		<u>282</u>
	<u>Fine Sand</u>		<u>292</u>

Information upon completion of well:

- (1) Diameter 4 inches.
- (2) Total Depth 292 feet.
- (3) Water Level 65 feet below top of ground.
- (4) Cased to 282, Size 2"
- (5) Screen: Size 2", Length 10ft
- (6) Were any formations sealed against pollution?
 yes, no.

If YES depth of formation _____
 Why _____
 Drillers Remarks: _____

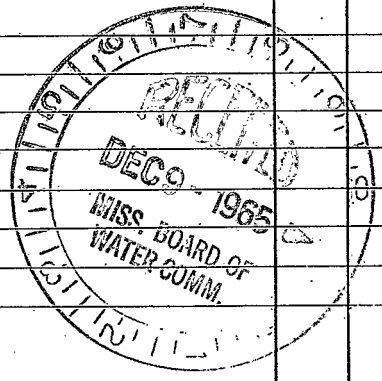

(Use Back Side)

Well No.

