

MISSISSIPPI BOARD OF WATER COMMISSIONERS

SCOTT
 264
 8-1-61

T WATER WELL DRILLERS LOG

G N


Date: 8/1, 1961, Driller: James McGee County Scott
 (Name)

	Description & Color of Materials Sand, Clay, Red Clay, Shell, etc.	Thick- ness Feet	Depth Feet
(1) Owner of Land: <u>Travis Chambers</u> (Name)	Clay.	0-	22
<u>Forest, Miss.</u> (Address)	Soft clay.	22-	32
This well located about 6 miles	Clay.	32-	72
(2) Location: <u>1/4</u> , <u>1/4</u> , Sec. <u>T R</u>	Clay & stks. sand.	72-	82
North of Forest on Hwy. 35 at	Clay.	82-	122
Texaco service sta. & store. miles of	Sand & stks. clay.	122-	132
(3) Topography: <u>x</u> (Hilly) (Flat) (Level)	Fine sand & stks. clay.	132-	152
(4) Purpose of Well: <u>For store & Ser. Sta.</u> (Domestic Irrigation Municipal, Industrial, Other)	Fine sand.	152-	162
	Clay & stks. sand.	162-	172
	Sand. (Screen setting)	172-	212

Information upon completion of well:

- (1) Diameter 2 inches.
- (2) Total Depth 212 feet.
- (3) Water Level 44 feet below top of ground.
- (4) Cased to 202', Size 2"
- (5) Screen: Size 2", Length 10'
- (6) Were any formations sealed against pollution?
no yes, x no.

If YES depth of formation _____
 Why _____
 Drillers Remarks: Good well.

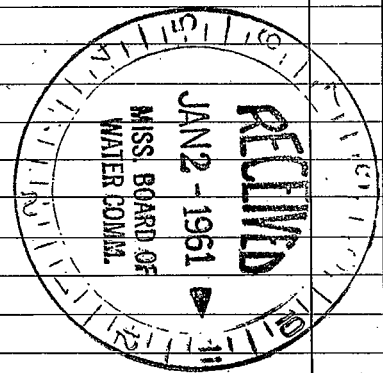

(Use Back Side)

Well No.

Retain this copy for your office files.

