

SCOTT MISSISSIPPI BOARD OF WATER COMMISSIONERS

G 5

11-29-63

WATER WELL DRILLERS LOG

4

Date: 11/29, 1963, Driller: Frank Dilling County Scott  
 (Name)


(1) Owner of Land: J. A. Riser  
 (Name)  
Rt 1 Forest, Miss  
 (Address)  
 (2) Location: 1/4, 1/4, Sec. 13 7N 8E  
 T R  
5 1/2 miles North of Forest  
 (distance) (direction) (Nearest Town)  
 (3) Topography:  (Hilly)  (Flat)  (Level)  
 (4) Purpose of Well: Home  
 (Domestic Irrigation  
 Municipal, Industrial, Other)

Description & Color of Materials Sand, Clay, Red Clay, Shell, etc.	Thick- ness Feet	Depth Feet
<u>Clay</u>	<u>0</u>	<u>22</u>
<u>Clay &amp; Sand</u>		<u>32</u>
<u>Clay &amp; Shaly Sand</u>		<u>42</u>
<u>Clay</u>		<u>102</u>
<u>Clay &amp; Shaly Sand</u>		<u>152</u>
<u>fine sand</u>		<u>168</u>
<u>Clay</u>		<u>175</u>
<u>fine sand</u>		<u>182</u>
<u>fine sand &amp; sh. clay</u>		<u>192</u>
<u>fine sand</u>		<u>212</u>
<u>hard sand</u>		<u>216</u>

Information upon completion of well:

(1) Diameter 2 inches.  
 (2) Total Depth 216 feet.  
 (3) Water Level 63 feet below top of ground.  
 (4) Cased to 206, Size 2"  
 (5) Screen: Size 2", Length 10 ft.  
 (6) Were any formations sealed against pollution?  
yes,  no.

If YES depth of formation \_\_\_\_\_  
 Why \_\_\_\_\_  
 Drillers Remarks: \_\_\_\_\_

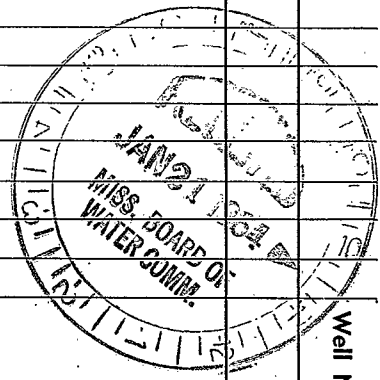

Well No.

(Use Back Side)

...the ...

...the ...

