

WATER WELL DRILLERS LOG

Date: 9/10, 1964, Driller: East Drilling Co County: Scott
 (Name)


(1) Owner of Land: Hugh Straker Jr.
 (Name)
Harperville Miss.
 (Address)
 (2) Location: 1/4, 1/4, Sec. 9 T. 1 R. 15 SE
6 miles North of Forest
 (distance) (direction) (Nearest Town)
 (3) Topography: X (Hilly) (Flat) (Level)
 (4) Purpose of Well: Home
 (Domestic Irrigation
 Municipal, Industrial, Other)

Description & Color of Materials Sand, Clay, Red Clay, Shell, etc.	Thick- ness Feet	Depth Feet
Red Clay	0	12
Clay + Sand		42
Sand		82
Clay + Shls Sand		122
Fine Sand		137
Clay		157
Clay + Shls Rock		217
Rock		227
Rock + Shls Clay		232
Clay + Sandy Shls		262
Fine Sand		272
Clay + Shls Fine Sand		282
Clay		362
Fine Sand		369
F. Sand + Shls Clay		392
Clay		396
Sand		402
Fine Sand		422
Good Sand		440

Information upon completion of well:

(1) Diameter 2 inches.
 (2) Total Depth 440 feet.
 (3) Water Level 198 feet below top of ground.
 (4) Cased to 425, Size 2"
 (5) Screen: Size 2", Length 15 ft
 (6) Were any formations sealed against pollution?
 _____ yes, X no.

If YES depth of formation _____
 Why _____
 Drillers Remarks: _____

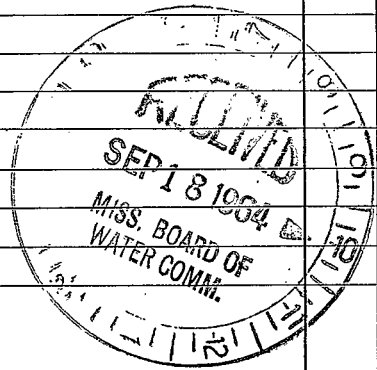

(Use Back Side)

Well No.

