

MISSISSIPPI
BOARD OF WATER COMMISSIONERS
416 North State Street
Jackson, Mississippi 39201

WATER WELL DRILLERS LOG

Scott
3 69
4-67

April 19 1967 date well completed
B.T. Wilkerson Drill. Serv. firm name
Scott county well located

LANDOWNER:

SAM Pryor
Harperville, Miss
(mailing address)

description of formations encountered

from to

| | | |
|--------------|-----|-----|
| CLAY yellow | 0 | 25 |
| SAND + CLAY | 25 | 90 |
| Rock + shale | 90 | 150 |
| blue CLAY | 150 | 250 |
| Brown shale | 250 | 320 |
| SAND | 320 | 383 |

WELL LOCATION:


sec. 14 T. 7 N. R. 8 E
1/4 mi. miles W. of E. Hillborn
(distance) (direction) (nearest town)

WELL PURPOSE: Home
(home, irrigation, municipal, industrial)

WELL COMPLETION DATA:


- diameter (inches) 2^{1/2}
- total depth (feet) 383
- static water level (feet) 140 below top of ground.
- casing Galv. S. (material), 378 (depth),
2" (size) if telescope see back.
- screen 5' (length), 378' (depth to top),
2" (size), Brass 10 Slot (material)
- pump 2 (HP), 6 (yield gpm)
Elec. (type power)
- electric log no (yes or no)
(organization running log)
- how well bottom plugged B.W. Valve

DRILLERS REMARKS:

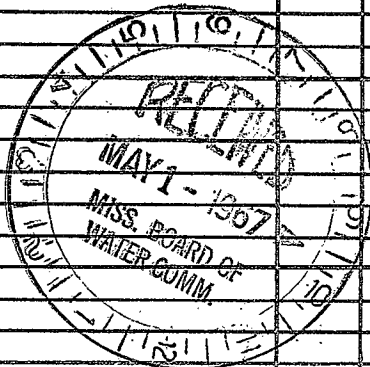

If well telescopes please sketch and show depths.

GROUND LEVEL

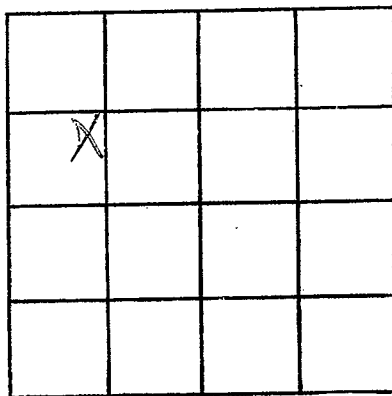

SECTION 16

Please indicate well location X.

ADDITIONAL INFORMATION

If more than one screen,
show locations of each on sketch.