

SCOTT
3 G 10
1-67

MISSISSIPPI
BOARD OF WATER COMMISSIONERS
416 North State Street
Jackson, Mississippi 39201

WATER WELL DRILLERS LOG

1-25 1967 date well completed
Fred Willing firm name
Scott county well located

LANDOWNER: H.H. Arslan
Miller Farms

description of formations encountered	from	to
Clay	0	61
Clay & Shs. & Sand	61	102
Clay	102	220
Fine Sand	220	225
Clay	225	266
Clay & Shs. Rock	266	286
Clay	286	317
Rock	317	321
Clay & Rock	321	329
Sand & Clay	329	347
Fin Sand	347	378

Bergerville, Miss
(mailing address)


WELL LOCATION:
sec. 16 T. 7N R. 8E
1/4 miles West of E. Hillman
(distance) (direction) (nearest town)

WELL PURPOSE: Chicken farm
(home, irrigation, municipal, industrial)

WELL COMPLETION DATA:


- (1) diameter (inches) 2"
- (2) total depth (feet) 378
- (3) static water level (feet) 142 below top of ground.
- (4) casing Galv. 368 (material) (depth)
2" If telescope see back. (size)
- (5) screen 10 ft. 368 ft. (length) (depth to top)
2" Galv. (size) (material)
- (6) pump 3 800 GPH. (HP) (yield gpm)
220-1 ph. Elec. (type power)
- (7) electric log No. (yes or no)
- (organization running log)
- (8) how well bottom plugged 2" Bachman valve

DRILLERS REMARKS:

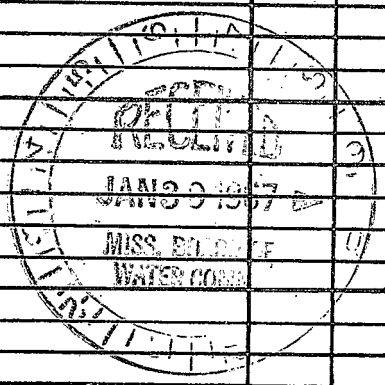

If well telescopes please sketch and show depths.

GROUND LEVEL

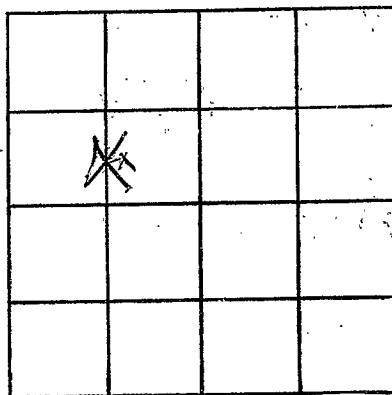

SECTION 16

Please indicate well location X.

ADDITIONAL INFORMATION

If more than one screen, show locations of each on sketch.