

SCOTT MISSISSIPPI BOARD OF WATER COMMISSIONERS

G11
4-13-66

WATER WELL DRILLERS LOG

Date: 4/13, 1966, Driller: James D. [unclear] County: Scott
(Name)

(1) Owner of Land: Miss. Roy [unclear]
(Name)
Haverhill, Miss.
(Address)

(2) Location: 1/4, 1/4, Sec. 4 T 1 R
1/2 miles S. East of Haverhill
(distance) (direction) (Nearest town)

(3) Topography: ✓
(Hilly) (Flat) (Level)

(4) Purpose of Well: Home
(Domestic Irrigation
Municipal, Industrial, Other)

Description & Color of Materials Sand, Clay, Red Clay, Shell, etc.	Thick- ness Feet	Depth Feet
<u>Red clay</u>		<u>10</u>
<u>to [unclear]</u>		<u>27</u>
<u>to [unclear]</u>		<u>27</u>
<u>fine sand</u>		<u>110</u>
<u>fine sand</u>		<u>122</u>

Information upon completion of well:

(1) Diameter 2 inches.

(2) Total Depth 122 feet.


(3) Water Level 27 feet below top of ground.

(4) Cased to 117, Size 2"

(5) Screen: Size 2", Length 5 ft

(6) Were any formations sealed against pollution?
✓ yes, no.

If YES depth of formation _____
Why _____
Drillers Remarks: _____

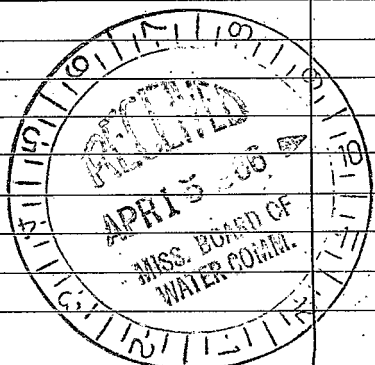

(Use Back Side)

Well No.

