

SCOTT MISSISSIPPI BOARD OF WATER COMMISSIONERS

G12  
 5 10-15-65 WATER WELL DRILLERS LOG

Date: 10/15, 1965, Driller: Forrest Dilling county Scott  
 (Name)


(1) Owner of Land: Fred Gaddis and  
 (Name)  
Just Miss  
 (Address)  
 (2) Location: 1/4, 1/4, Sec. 4 T. R  
1 miles South of Harper  
 (distance) (direction) (Nearest Town)  
 (3) Topography: Level  
 (Hilly) (Flat) (Level)  
 (4) Purpose of Well: Chicken farm  
 (Domestic Irrigation  
 Municipal, Industrial, Other)

Description & Color of Materials Sand, Clay, Red Clay, Shell, etc.	Thick- ness Feet	Depth Feet
<u>Red Clay</u>		<u>16</u>
<u>Red sand + Clay</u>		<u>22</u>
<u>Clay + Sh + Mly. Dul</u>		<u>92</u>
<u>Fine sand</u>		<u>102</u>
<u>Fine sand</u>		<u>142</u>
<u>Good sand</u>		<u>152</u>

Information upon completion of well:

(1) Diameter 2 inches.  
 (2) Total Depth 152 feet.  
 (3) Water Level 45 feet below top of ground.  
 (4) Cased to 142, Size 2"  
 (5) Screen: Size 2", Length 10ft  
 (6) Were any formations sealed against pollution?  
no

If YES depth of formation \_\_\_\_\_  
 Why \_\_\_\_\_  
 Drillers Remarks: \_\_\_\_\_

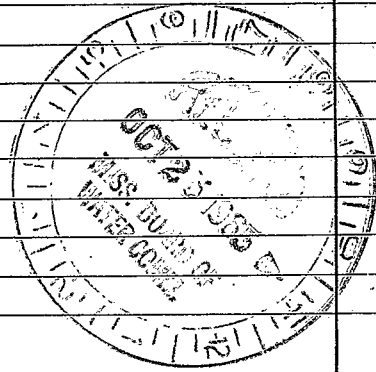

(Use Back Side)

Well No.

