

SCOTT

G 12

9-16-64

WATER WELL DRILLERS LOG

Date: 9/16, 1964, Driller: Rust Dillingen, County: Nesh

(1) Owner of Land: Bill Neuland (Name) Hillsboro Miss. (Address)

(2) Location: 1/4, 1/4, Sec. T R 1/4 miles N. (distance) (direction) of Fair Chandler (Nearest Town)

(3) Topography: (Hilly) (Flat) (Level)


(4) Purpose of Well: Home (Domestic Irrigation Municipal, Industrial, Other)

Table with 3 columns: Description & Color of Materials, Thickness Feet, Depth Feet. Contains handwritten entries for soil layers like Red Clay, Clay + silt, etc.

Information upon completion of well:

- (1) Diameter 2 inches.
(2) Total Depth 212 feet.
(3) Water Level 22 feet below top of ground.
(4) Cased to 202, Size 2"
(5) Screen: Size 2", Length 10ft.
(6) Were any formations sealed against pollution?

yes, X no.
If YES depth of formation
Why
Drillers Remarks:

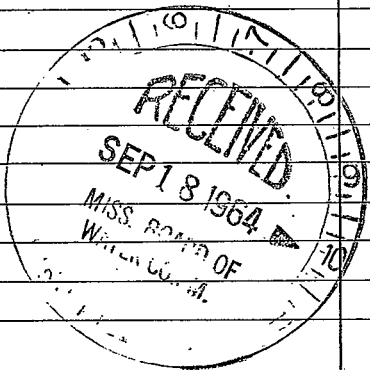

(Use Back Side)

Well No.

