

SCOTT MISSISSIPPI BOARD OF WATER COMMISSIONERS

G16 T

5-27-65 WATER WELL DRILLERS LOG

Date: 5/27, 1965, Driller: Forest Willing County Scott
 (Name)

(1) Owner of Land: Norman Thomas
 (Name)
Forest, Miss.
 (Address)

(2) Location: 1/4, 1/4, Sec 23 14 35
 T 14 R 35
5 miles North of Forest
 (distance) (direction) (Nearest Town)

(3) Topography: (Hilly) (Flat) (Level)

(4) Purpose of Well: Home
 (Domestic Irrigation
 Municipal, Industrial, Other)

Description & Color of Materials Sand, Clay, Red Clay, Shell, etc.	Thick- ness Feet	Depth Feet
<u>Brown Clay</u>		<u>27</u>
<u>Blue Clay</u>		<u>37</u>
<u>Clay & sandy Shell</u>		<u>52</u>
<u>Clay</u>		<u>59</u>
<u>Rock</u>		<u>62</u>
<u>Clay</u>		<u>92</u>
<u>Clay & Shs. Fin Sand</u>		<u>112</u>
<u>Clay</u>		<u>142</u>
<u>Fine Sand</u>		<u>182</u>
<u>Fine Sand & Shs. Clay</u>		<u>212</u>
<u>Fine Sand</u>		<u>222</u>
<u>Clay & Shs. Fin Sand</u>		<u>228</u>
<u>Fine Sand - Good</u>		<u>242</u>
<u>Good Sand</u>		<u>252</u>

Information upon completion of well:

(1) Diameter 2 inches.

(2) Total Depth 251 feet.

(3) Water Level 69 feet below top of ground.

(4) Cased to 241, Size 2"


(5) Screen: Size 2", Length 10

(6) Were any formations sealed against pollution?
 _____ yes, no.

If YES depth of formation _____

Why _____

Drillers Remarks: _____

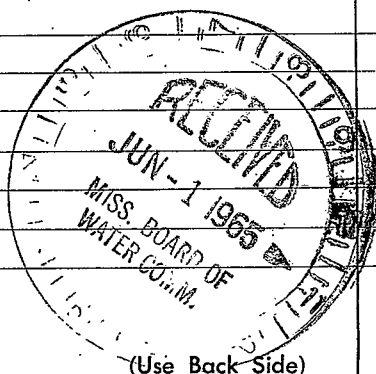

Well No. _____

