

WATER WELL DRILLERS LOG

Date: 2/7, 1964, Driller: Just Bily County: Scott
 (Name)

(1) Owner of Land: Otis Carpenter
 (Name)
Rt 4 Fruit, Miss.
 (Address)
 (2) Location: 9 ^{701 SE} T R
5 miles North of Fruit
 (distance) (direction) (Nearest Town)
 (3) Topography: Hilly
 (Hilly) (Flat) (Level)
 (4) Purpose of Well: Home
 (Domestic Irrigation
 Municipal, Industrial, Other)


Description & Color of Materials Sand, Clay, Red Clay, Shell, etc.	Thick- ness Feet	Depth Feet
Red clay	0	6
Red + Sh. Clay		104
Clay		112
Clay + Sh. Sand		132
Clay		159
Rock		162
Clay + Sh. Rock		202
Clay		215
Rock		222
Rock + Clay		232
Fine sand + Sh. clay		242
Fine sand		252
Fine sand		272

Information upon completion of well:

(1) Diameter 2 inches.
 (2) Total Depth 272 feet.
 (3) Water Level 107 feet below top of ground.
 (4) Cased to 262, Size 2"
 (5) Screen: Size 2", Length 10ft
 (6) Were any formations sealed against pollution?
 _____ yes, X no.

If YES depth of formation _____
 Why _____

Drillers Remarks: _____

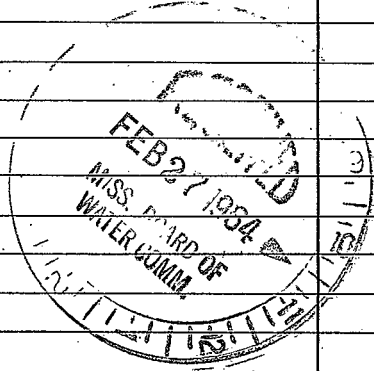

(Use Back Side)

Well No.

100

101

102

200