

SCOTT MISSISSIPPI BOARD OF WATER COMMISSIONERS

G18
6-25-63

WATER WELL DRILLERS LOG

Date: 6-25, 1963, Driller: Foot Driller County Scott
(Name)

(1) Owner of Land: D. B. Burns
(Name)
Hillshoer, Miss.
(Address)

(2) Location: 1/4, 1/4, Sec. 7 T R
1/2 miles West, of Hillshoer
(distance) (direction) (Nearest Town)

(3) Topography: X
(Hilly) (Flat) (Level)

(4) Purpose of Well: Home
(Domestic Irrigation
Municipal, Industrial, Other)

Description & Color of Materials Sand, Clay, Red Clay, Shell, etc.	Thick- ness Feet	Depth Feet
<u>yellow clay</u>	<u>0</u>	<u>24</u>
<u>blue clay</u>		<u>162</u>
<u>Fine Sand & Shell</u>		<u>189</u>
<u>Fine sand</u>		<u>246</u>
<u>Med. Sand</u>		<u>256</u>

Information upon completion of well:

(1) Diameter 2' inches.

(2) Total Depth 255 feet.

(3) Water Level 60 feet below top of ground.

(4) Cased to 245, Size 2"


(5) Screen: Size 2", Length 10 ft.

(6) Were any formations sealed against pollution?
_____ yes, X no.

If YES depth of formation _____

Why _____

Drillers Remarks: _____

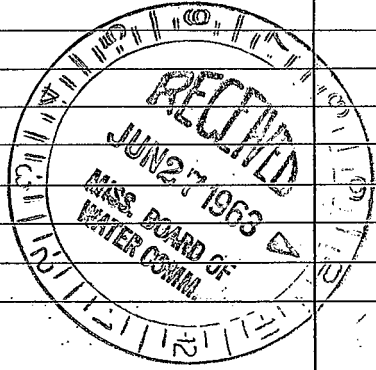

(Use Back Side)

Well No.

