

SCOTT MISSISSIPPI BOARD OF WATER COMMISSIONERS

3 G20 T 9-11-62 WATER WELL DRILLERS LOG

Date: 9-11-1, 1962, Driller Faust Drilling Co County Scott
 (Name)

(1) Owner of Land: B. T. Sanders
 (Name)
Rt 1 Faust, Miss.
 (Address)
 (2) Location: 1/4, 1/4, Sec. 23 T 1 R 1
5 miles North of Faust
 (distance) (direction) (Nearest Town)
 (3) Topography: (Level)
 (Hilly) (Flat) (Level)
 (4) Purpose of Well: Stew
 (Domestic Irrigation Municipal, Industrial, Other)


Description & Color of Materials Sand, Clay, Red Clay, Shell, etc.	Thick- ness Feet	Depth Feet
<u>Red Clay</u>	<u>0</u>	<u>12</u>
<u>Sand</u>	<u>62</u>	<u>62</u>
<u>Sand</u>	<u>131</u>	<u>131</u>

Information upon completion of well:

(1) Diameter 2" inches.
 (2) Total Depth 131 feet.
 (3) Water Level 60ft feet below top of ground.
 (4) Cased to 126, Size 2"
 (5) Screen: Size 3", Length 5ft
 (6) Were any formations sealed against pollution?
 _____ yes, no.

If YES depth of formation _____
 Why _____

Drillers Remarks: _____

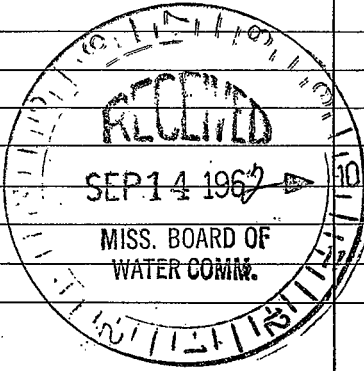

(Use Back Side)

Well No.

