

G 24

7-29-65

WATER WELL DRILLERS LOG

Date: 7/29, 1965, Driller: Forrest Dilling County Scott
 (Name)

(1) Owner of Land: Hubert L Smith
 (Name)
At 1 Frank Moss
 (Address)

(2) Location: 1/4, 1/4, Sec. 35 T. 10 R. 10
4 miles N.E. of Forrest
 (distance) (direction) (Nearest Town)

(3) Topography: (Level)
 (Hilly) (Flat)

(4) Purpose of Well: Home
 (Domestic Irrigation
 Municipal, Industrial, Other)

Description & Color of Materials Sand, Clay, Red Clay, Shell, etc.	Thick- ness Feet	Depth Feet
<u>Clay</u>	<u>8</u>	<u>12</u>
<u>Clay + Red Sand</u>		<u>24</u>
<u>Clay</u>		<u>62</u>
<u>Clay & Sand</u>		<u>72</u>
<u>Red Sand + Clay</u>		<u>92</u>
<u>Clay Sand</u>		<u>131</u>

Information upon completion of well:

(1) Diameter 2 inches.

(2) Total Depth 131 feet.


(3) Water Level 50 feet below top of ground.

(4) Cased to 126, Size 2"

(5) Screen: Size 2", Length 5 ft

(6) Were any formations sealed against pollution?
 _____ yes, no.

If YES depth of formation _____
 Why _____
 Drillers Remarks: _____

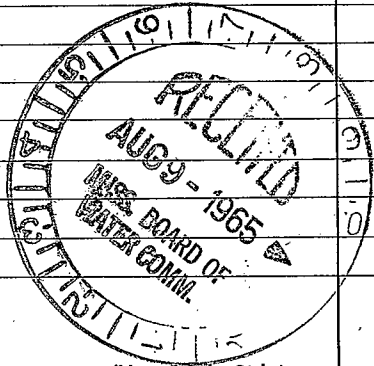

(Use Back Side)

Well No.

