

6
 SCOTT
 G 45
 5/19-64

MISSISSIPPI BOARD OF WATER COMMISSIONERS
WATER WELL DRILLERS LOG

Date: 5/19, 1964, Driller: Frost Drilling Service County: Scott
 (Name)

(1) Owner of Land: Fred G. Galtis, Jr.
 (Name) #4
Frost, Miss
 (Address)
 (2) Location: 1/4, 1/4, Sec. 21 T. 11 R. 11
3 1/2 miles Northw. of Frost
 (distance) (direction) (Nearest Town)
 (3) Topography: _____
 (Hilly) (Flat) (Level)
 (4) Purpose of Well: Chickens
 (Domestic Irrigation
 Municipal, Industrial, Other)


Description & Color of Materials Sand, Clay, Red Clay, Shell, etc.	Thick- ness Feet	Depth Feet
<u>Chalky Clay</u>		<u>24</u>
<u>B. Clay & shls shale</u>		<u>49</u>
<u>B. Clay + Lignite</u>		<u>64</u>
<u>Black Clay</u>		<u>102</u>
<u>B. Clay + shls Lignite</u>		<u>144</u>
<u>shlt + shls shale</u>		<u>160</u>
<u>B. Clay</u>		<u>184</u>
<u>F. sand + shls shale</u>		<u>215</u>
<u>Fine sand</u>		<u>224</u>
<u>Sand + shls shale</u>		<u>235</u>
<u>Fine sand</u>		<u>252</u>
<u>F. sand + shls shale</u>		<u>264</u>
<u>Fine sand</u>		<u>276</u>

Information upon completion of well:

(1) Diameter 2 inches.
 (2) Total Depth 276 feet.
 (3) Water Level 90' feet below top of ground.
 (4) Cased to 266', Size 2"
 (5) Screen: Size 2", Length 10ft.
 (6) Were any formations sealed against pollution?
 _____ yes, X no.

If YES depth of formation _____
 Why _____

Drillers Remarks: _____

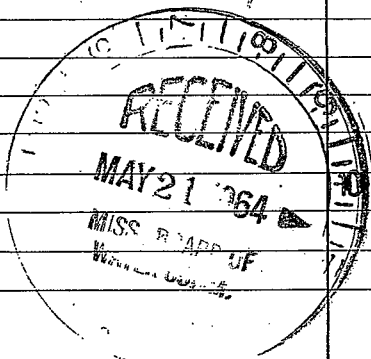

(Use Back Side)

Well No.

