

SCOTT

G 27  
5-21-63

WATER WELL DRILLERS LOG

Date: 5/21, 1963, Driller: Forest Dwyer County Scott  
(Name)

(1) Owner of Land: R. L. New, Jr.  
(Name)  
Harperville, Miss  
(Address)

(2) Location: 1/4, 1/4, Sec. 1 T 1 R  
5 miles North of Forest  
(distance) (direction) (Nearest Town)

(3) Topography: X  
(Hilly) (Flat) (Level)

(4) Purpose of Well: Chicken  
(Domestic Irrigation  
Municipal, Industrial, Other)

Description & Color of Materials Sand, Clay, Red Clay, Shell, etc.	Thick- ness Feet	Depth Feet
Clay	0	42
Clay & mdy sand		62
Clay		92
Fine sand & fths clay		102
Fine sand		122
Fine sand		127
Clay & sand		132
Clay & fths sand		160
Fine sand		175

Information upon completion of well:

(1) Diameter 2" inches.

(2) Total Depth 175 feet.

(3) Water Level \_\_\_\_\_ feet below top of ground.

(4) Cased to 165', Size 2"


(5) Screen: Size 2", Length 10 ft.

(6) Were any formations sealed against pollution?  
\_\_\_\_\_ yes, X no.

If YES depth of formation \_\_\_\_\_

Why \_\_\_\_\_

Drillers Remarks: \_\_\_\_\_

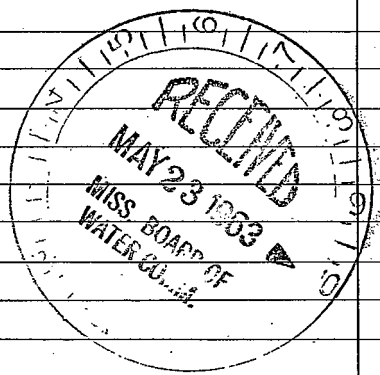

(Use Back Side)

Well No.

The following information was obtained from the records of the  
 Bureau of the Census, Department of Commerce, Washington, D. C.  
 for the year 1954. The information is presented in the form of  
 a table showing the number of persons in the United States  
 who were born in each foreign country and who were  
 naturalized citizens of the United States in 1954. The  
 information is presented in the form of a table showing the  
 number of persons in the United States who were born in each  
 foreign country and who were naturalized citizens of the  
 United States in 1954. The information is presented in the  
 form of a table showing the number of persons in the United  
 States who were born in each foreign country and who were  
 naturalized citizens of the United States in 1954.