

SCOTT MISSISSIPPI BOARD OF WATER COMMISSIONERS

G32
1-8-63

WATER WELL DRILLERS LOG

Date: 18, 1962, Driller: LEACH County: SCOTT
(Name)


(1) Owner of Land: EE. MAY
(Name)
LAKE MISS
(Address)
(2) Location: 1/4, 1/4, Sec. 16 T. R
6 miles N of Forest
(distance) (direction) (Nearest Town)
(3) Topography: Hilly
(Hilly) (Flat) (Level)
(4) Purpose of Well: Domestic
(Domestic Irrigation
Municipal, Industrial, Other)

Description & Color of Materials Sand, Clay, Red Clay, Shell, etc.	Thick- ness Feet	Depth Feet
<u>Red clay</u>	<u>15</u>	
<u>Blue m</u>	<u>60</u>	<u>75</u>
<u>Clay Sand</u>	<u>50</u>	<u>125</u>
<u>SAND</u>	<u>48</u>	<u>173</u>

Information upon completion of well:

(1) Diameter 2" inches.
(2) Total Depth 173 feet.
(3) Water Level 73 feet below top of ground.
(4) Cased to 173, Size 2"
(5) Screen: Size 2", Length 6'
(6) Were any formations sealed against pollution?
✓ yes, no.

If YES depth of formation 60
Why fine sand
Drillers Remarks:

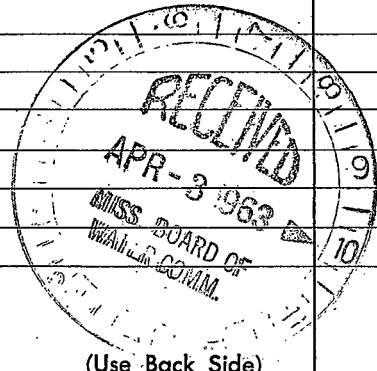

Well No.

1944

1944

