

SCOTT MISSISSIPPI BOARD OF WATER COMMISSIONERS

G 39 T  
8-6-63

WATER WELL DRILLERS LOG

Date: 8/6, 1963, Driller: Frank Dwyer County: Scott  
(Name)

(1) Owner of Land	Description & Color of Materials Sand, Clay, Red Clay, Shell, etc.	Thick-ness Feet	Depth Feet
<u>John W. Edwards</u> (Name)	<u>Clay</u>	<u>0</u>	<u>22</u>
<u>Rt of Frank Dwyer</u> (Address)	<u>Clay + red sand</u>		<u>32</u>
	<u>sand</u>		<u>65</u>
(2) Location: <u>1/4</u> , <u>1/4</u> , Sec. <u>4</u> T <u>R</u>	<u>Clay</u>		<u>82</u>
<u>8</u> miles <u>North</u> of <u>Frank</u>	<u>Clay + rock</u>		<u>92</u>
(distance) (direction) (Nearest Town)	<u>Clay + sh. rock</u>		<u>132</u>
(3) Topography: _____	<u>Clay</u>		<u>146</u>
(Hilly) (Flat) (Level)	<u>rock + sh. clay</u>		<u>152</u>
(4) Purpose of Well: <u>Home</u>	<u>Clay + sh. rock</u>		<u>162</u>
(Domestic Irrigation Municipal, Industrial, Other)	<u>Fine sand</u>		<u>220</u>
	<u>gravel</u>		<u>242</u>


Information upon completion of well:

- (1) Diameter 2" inches.
- (2) Total Depth 270 feet.
- (3) Water Level 80 feet below top of ground.
- (4) Cased to 210, Size 2"
- (5) Screen: Size 2", Length 12ft
- (6) Were any formations sealed against pollution?  
\_\_\_\_\_ yes, X no.

If YES depth of formation \_\_\_\_\_

Why \_\_\_\_\_

Drillers Remarks: \_\_\_\_\_

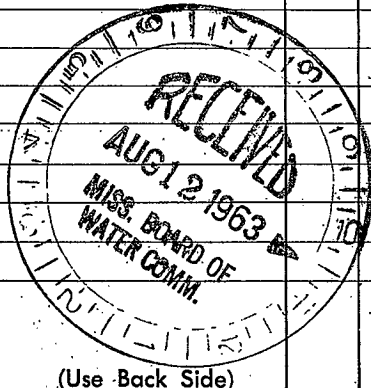

(Use Back Side)

Well No.

