

MISSISSIPPI BOARD OF WATER COMMISSIONERS

SCOTT
 G43
 8-2-60

CODED
~~no 946~~
 WATER WELL DRILLERS LOG
 CODED

0300

Date: 8/2 1960, Driller: James McGee County: Scott
 (Name)


(1) Owner of Land: North. Scott Co. Schools
 (Name)
Forest, Miss.
 (Address)
 (2) Location: Center 13-8N-16
 1/4, 1/4, Sec. 7 R
10 miles North of Forest
 (distance) (direction) (Nearest Town)
 (3) Topography: X
 (Hilly) (Flat) (Level)
 (4) Purpose of Well: Colored School
 (Domestic Irrigation
 Municipal, Industrial, Other)

Description & Color of Materials Sand, Clay, Red Clay, Shell, etc.	Thick- ness Feet	Depth Feet
Brown Clay.	0	16
Red Sand.	16	32
Sand & Stks. Clay.	32	122
Clay.	122	132
Clay & Stks. Lime		
Rock.	132	142
Clay.	142	162
Clay & Stks. Rock.	162	172
Clay.	172	202
Clay & Stks. Rock.	202	218
Fine Sand & Clay.	218	228
Fine Sand.	228	232
Fine Sand & Stks. Clay	232	244
Fine Sand.	244	294
Fine Sand.	294	312
Sand. (Screen Set)	312	352

Information upon completion of well:

(1) Diameter 4x2 1/2 inches.
 (2) Total Depth 352 feet.
 (3) Water Level 102 feet below top of ground.
 (4) Cased to 302, Size 294' 4 1/2"
18' 2 1/2"
 (5) Screen: Size 2 1/2", Length 40'
 (6) Were any formations sealed against pollution?
yes, X no.

CODED

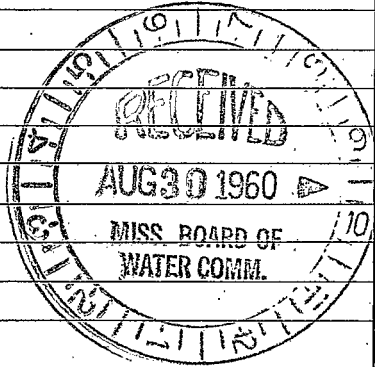

If YES depth of formation _____
 Why _____
 Drillers Remarks: Good well

(Use Back Side)

Well No.

