

*Scott*  
 G45  
 8-1-68

MISSISSIPPI  
 BOARD OF WATER COMMISSIONERS  
 416 North State Street  
 Jackson, Mississippi 39201

WATER WELL DRILLERS LOG

CODED

8-1-1968 date well completed  
 Bonanza Drilling firm name  
 Scott county well located

LANDOWNER: *ROBERT GUNTER*

description of formations encountered

from

to

*NO. OF WOLF STORE 1/2 MI.*

*SURFACE CLAY*

*0*

*12*

*Four Cont. 3 1/2 Miles*  
 (mailing address)

*FINE SILTY SAND*

*12*

*98*

*COURSE SAND*

*98*

*130*

WELL LOCATION:

sec. *12* T *7* N R *8* E  
 S W  
*10* miles *NORTH* of *Forest*  
 (distance) (direction) (nearest town)

WELL PURPOSE: *HOME*  
 (home, irrigation, municipal, industrial)

WELL COMPLETION DATA:

(1) diameter (inches) *2"*

(2) total depth (feet) *130'*

(3) static water level (feet) *27'* below top of ground.

(4) casing *2 1/2"* *126'*  
 (material) (depth)

CODED

\_\_\_\_\_ if telescope see back.  
 (size)

(5) screen *5'* *126'*  
 (length) (depth to top)

*1 1/2"* *STAINLESS STEEL*  
 (size) (material)

(6) pump *3/4* *gal*  
 (HP) (yield gpm)

\_\_\_\_\_ (type power)

(7) electric log *NO*  
 (yes or no)

\_\_\_\_\_ (organization running log)

(8) how well bottom plugged \_\_\_\_\_


FEB 12 1969

DRILLERS REMARKS:

MISS. BD. OF  
 WATER COMM.

If well telescopes please sketch and show depths.

GROUND LEVEL

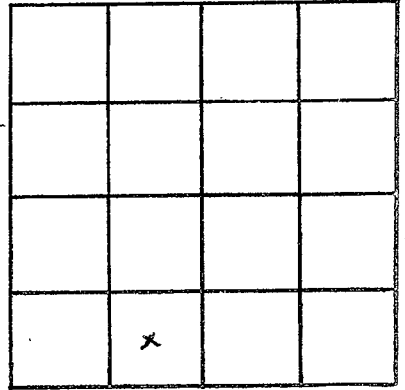

SECTION 12

Please indicate well location X.

ADDITIONAL INFORMATION

If more than one screen, show locations of each on sketch.