

SCOTT  
**G46**  
 3-3-61

MISSISSIPPI BOARD OF WATER COMMISSIONERS

**WATER WELL DRILLERS LOG**

**3**  
**CODED**

Date: 3/3, 1961, Driller: James McGee County Scott  
 (Name)

(1) Owner of Land: Richard Ware.  
 This well located <sup>(Name)</sup> North of Forest on  
Forest, Miss.  
<sup>(Address)</sup>  
Hwy. 35 at Harpeville, Miss.  
 (2) Location: 1/4, 1/4, Sec. 4 T 7 RB  
9 miles North of Forest  
 (distance) (direction) (Nearest Town)  
 (3) Topography: x  
 (Hilly) (Flat) (Level)  
 (4) Purpose of Well: Domestic.  
 (Domestic Irrigation  
 Municipal, Industrial, Other)


Description & Color of Materials Sand, Clay, Red Clay, Shell, etc.	Thick- ness Feet	Depth Feet
Clay.		0-12
Sand.		12-63
Brown sand.		63-72
Hard clay.		72-152
Hard clay & rock.		152-182
Clay & stks. sand.		182-192
Fine sand & stks. clay.		192-202
Clay.		202-206
Sand. (Screen setting)		206-220

Information upon completion of well:

(1) Diameter 2 inches.  
 (2) Total Depth 220' feet.  
 (3) Water Level 118' feet below top of ground.  
 (4) Cased to 210, Size 2"  
 (5) Screen: Size 2", Length 10'  
 (6) Were any formations sealed against pollution?  
yes, x no.

If YES depth of formation \_\_\_\_\_  
 Why \_\_\_\_\_  
 Drillers Remarks: Good well.

**CODED**

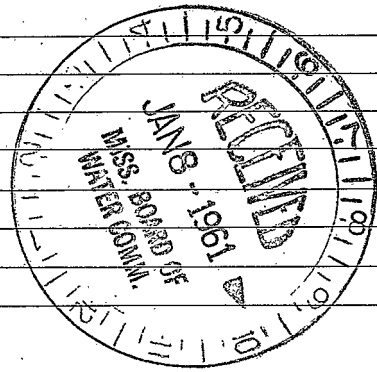

(Use Back Side)

Well No.

1000

1000

