

Scott  
G.49  
12-7-67

MISSISSIPPI  
 BOARD OF WATER COMMISSIONERS  
 416 North State Street  
 Jackson, Mississippi 39201

CODED

WATER WELL DRILLERS LOG

12-7 1967 Common Drilling Co. Scott  
 date well completed firm name county well located

LANDOWNER: Barnes Wright

description of formations encountered	from	to
	<u>Clay</u>	<u>0</u>
<u>Sand</u>	<u>38</u>	<u>46</u>

Font R#3 Area  
 (mailing address)

WELL LOCATION:  
 sec. 12 T. 7 N R. 8 E  
                   S                  W  
5 miles N of Font  
 (distance) (direction) (nearest town)

WELL PURPOSE: Home  
 (home, irrigation, municipal, industrial)

WELL COMPLETION DATA:

- (1) diameter (inches) 2"
- (2) total depth (feet) 45
- (3) static water level (feet) 35 below top of ground.
- (4) casing Steel 40  
 (material) (depth)  
1/4 if telescope see back.  
 (size)
- (5) screen 5 40  
 (length) (depth to top)  
1/4 5/16  
 (size) (material)
- (6) pump 1/2 300 GPH  
 (HP) (yield gpm)
- (type power)
- (7) electric log X  
 (yes or no)  
 (organization running log)
- (8) how well bottom plugged

CODED


FEB 12 1968

MISS. BD. OF  
 WATER COMM.

DRILLERS REMARKS:

If well telescopes please sketch and show depths.

GROUND LEVEL

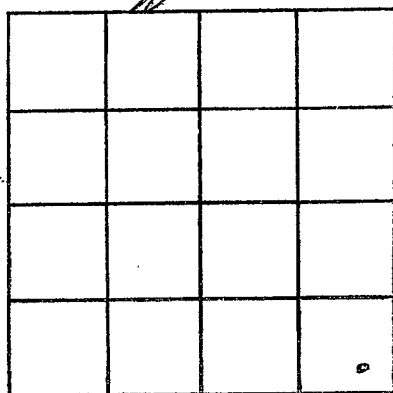

SECTION 12

Please indicate well location X.

ADDITIONAL INFORMATION

If more than one screen,  
show locations of each on sketch.