

Scott  
G2000  
2/79

MISSISSIPPI  
BOARD OF WATER COMMISSIONERS  
416 North State Street  
Jackson, Mississippi 39201

WATER WELL DRILLERS LOG

Feb 1979  
date well completed

Thomps  
firm name

Scott  
county well located

LANDOWNER: Mr. Terry Mapp

Forest MS

(mailing address)

WELL LOCATION:

sec. 33 T 7 (N) R 8 (E)  
2 miles N of Forest  
(distance) (direction) (nearest town)

WELL PURPOSE:

(home, irrigation, municipal, industrial)

WELL COMPLETION DATA:

- (1) diameter (inches) 2
- (2) total depth (feet) 275
- (3) static water level (feet) 70 <sup>below</sup> <sub>above</sub> top of ground.
- (4) casing PVC, 255 (material) (depth)  
2 (size) if telescope see back.
- (5) screen 20, 255 (length) (depth to top)  
2" 3/8 slot PVC (size) (material)
- (6) pump Air Lift 15 (HP) (yield gpm)  
5 kw (type power)
- (7) electric log NO (yes or no)
- (8) how well bottom plugged Sealed

description of formations encountered

from to

DIRT	0	15
CHALK	15	28
BLACK DIRT & STICKY SAND	28	34
FINE SAND & CHALK	34	122
Lime	122	130
Mixed up SAND & CHALK	130	255
Coarse SAND W/STH	255	275
CHALK		

DRILLERS REMARKS:


Miss. Board of Water Comm.

APR 4 - 1979

RECEIVED

If well telescopes please sketch and show depths.

GROUND LEVEL

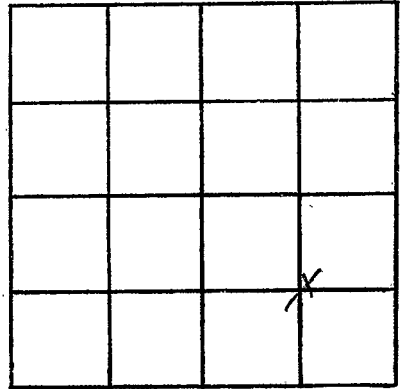

SECTION 33

Please indicate well location X.

ADDITIONAL INFORMATION

If more than one screen, show locations of each on sketch.