

SNHT

G 2001

6-5-80

6-5

MISSISSIPPI
 BOARD OF WATER COMMISSIONERS
 416 North State Street
 Jackson, Mississippi 39201

WATER WELL DRILLERS LOG

date well completed

firm name

county well located

19 80 Thomas & Son Scott

LANDOWNER: B.W. McCarty

Forest Ms.

(mailing address)

WELL LOCATION:

sec. 33 T 7 N R 3 E
 S W
2 miles N of Forest
 (distance) (direction) (nearest town)

WELL PURPOSE:

(home, irrigation, municipal, industrial)

WELL COMPLETION DATA:

- (1) diameter (inches) 2
- (2) total depth (feet) 240
- (3) static water level (feet) 40 ^{below}/_{above} top of ground.
- (4) casing PVC, 230,
 (material) (depth)
2 if telescope see back.
 (size)
- (5) screen 10, 230
 (length) (depth to top)
65 slot 2" PVC
 (size) (material)
- (6) pump old Air Comp. 20
 (HP) (yield gpm)
Etc.
 (type power)
- (7) electric log No.
 (yes or no)

(organization running log)

(8) how well bottom plugged Perf

DRILLERS REMARKS:

description of formations encountered

from

to

<u>fine CLAY</u>	<u>0</u>	<u>15</u>
<u>Grey CHALK</u>	<u>15</u>	<u>36</u>
<u>ROCK</u>	<u>36</u>	<u>37</u>
<u>Grey SAND</u>	<u>37</u>	<u>55</u>
<u>BLACK DIRT</u>	<u>55</u>	<u>75</u>
<u>SAND</u>	<u>75</u>	<u>110</u>
<u>BLACK DIRT</u>	<u>110</u>	<u>135</u>
<u>ALL SAND</u>	<u>135</u>	<u>240</u>


DEPT. OF NATURAL RESOURCES
 BUREAU OF LAND & WATER RESOURCES

JUL 16 1980

RECEIVED

If well telescopes please sketch and show depths.

GROUND LEVEL

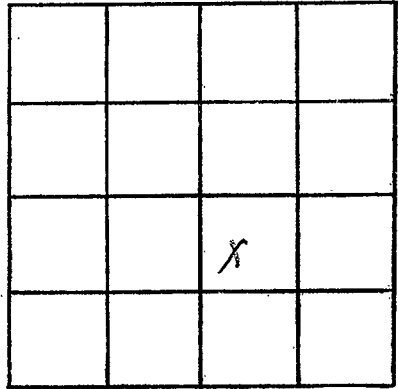

SECTION 33

Please indicate well location X.

ADDITIONAL INFORMATION

If more than one screen,
show locations of each on sketch.