

Scott
G
2003
MS-GW-14556

MISSISSIPPI
BOARD OF WATER COMMISSIONERS
416 North State Street
Jackson, Mississippi 39201

WATER WELL DRILLERS LOG

2-5-1982 date well completed THOMAS firm name SCOTT county well located

LANDOWNER: RONALD ALLEN
Hillsborough, MS.
(mailing address)

description of formations encountered	from	to
DIRT	0	30
SAND	30	155

WELL LOCATION:
13 T 7 S R 8 E W
5 miles N of Forest
(distance) (direction) (nearest town)

WELL PURPOSE:
(home, irrigation, municipal, industrial)

WELL COMPLETION DATA:

(1) diameter (inches) 10

(2) total depth (feet) 155

(3) static water level (feet) 10 ^{below} above top of ground.

(4) casing PVC, 35 (material) (depth)

10 (size) if telescope see back.

(5) screen 120, 35 (length) (depth to top)

10, PVC (size) (material)

(6) pump 60, 700RPM (HP) (yield gpm)

Diesel (type power)

(7) electric log NO (yes or no)

(organization running log)

(8) how well bottom plugged Point

DRILLERS REMARKS: East of Hillsborough

DEPT. OF NATURAL RESOURCES
BUREAU OF LAND & WATER RESOURCES


APR - 9 1982

RECEIVED

(X)

If well telescopes please sketch and show depths.

GROUND LEVEL

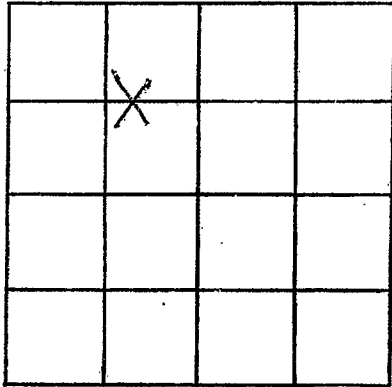

SECTION 107

Please indicate well location X.

ADDITIONAL INFORMATION

Lined area for additional information.

If more than one screen, show locations of each on sketch.