

**MISSISSIPPI DEPARTMENT OF ENVIRONMENTAL QUALITY**

Office of Land and Water Resources

P. O. Box 10631  
Jackson, MS 39289-0631

**WATER WELL DRILLERS LOG**

COUNTY, WELL LOCATED <b>SCOTT</b>	
WELL NUMBER <b>1</b>	CODED
DATE WELL COMPLETED <b>7-15-00</b>	

PERMIT NUMBER
NAME OF DRILLING FIRM <b>GARDNER DRILLING</b>
<b>SEBASTOPOL, MS. 39339</b>

NAME & MAILING ADDRESS OF LANDOWNER <b>JIMMY BRADFORD</b>			
<b>498 N. LITTLE RIVER RD.</b>			
<b>FOREST, MS. 39074</b>			
WELL LOCATION	SEC	TOWNSHIP	RANGE
	<b>9</b>	<b>7</b>	<b>8</b>
		<b>N</b>	<b>E</b>
		<b>S</b>	<b>W</b>
DISTANCE	DIRECTION	NEAREST TOWN	
<b>7</b> Miles	<b>N</b>	of <b>FOREST</b>	
OTHER LANDMARK			
WELL PURPOSE Home, Irrigation, Municipal, Industrial, Fish Pond, etc. <b>Irrigation</b>			

PUMP DATA			
PUMP TYPE (Circle One): <input checked="" type="checkbox"/> Submersible, Turbine, Jet, Flowing Well, Other (Describe) _____			
POWER TYPE (Circle One): <input checked="" type="checkbox"/> Electric, Tractor, Diesel, Gasoline, Butane, Other (Describe) _____ H/P _____			
Pump Capacity (GPM)	No of Stages	Setting Depth	
<b>10</b>	<b>12</b>	<b>180</b> FT.	
PUMP TEST			
Well yielded <b>28</b> GPM with a drawdown of <b>10</b> ft. after <b>12</b> hours of pumping			

WELL DATA		
Well Depth <b>330</b>	Casing Diameter (In ) <b>4"</b>	Casing Length (Ft ) <b>200</b>
Type of Casing <b>PVC</b>	Hole Depth <b>330</b>	Depth to Static Water Level <b>108</b>
TYPE OF COMPLETION: (Circle One or More) Gravel Packed, Underreamed, <input checked="" type="checkbox"/> Telescoped, Natural Development, Open Hole, Other (Describe) _____		

LOG DATA	
TYPE OF LOG RUN (Circle One): No Log Run, Electric, Gamma Ray, Density, Sonic, Neutron, Other (Describe) _____	
Name of Organization Running Log	

WELL GROUTED TO A DEPTH OF _____ FEET
Type Grout (circle one): Cement, Bentonite, or Mix

GEOLOGIC DATA (Office Use Only)			
Surface Elev	Geologic Unit	Unit Thickness	Depth to Top
Subs. SWL	Date	Analysis	Aquifer Test

SCREEN DATA		
Diameter - Inches <b>2</b>	Length - Feet <b>20</b>	Slot Size - Inches <b>8</b>
Screen Type <b>PVC RiB</b>	Depth to Bottom - Feet <b>330</b>	


Driller's Remarks
<b>RECEIVED</b>
Top of Lap Pipe or Reduction in Casing
FEET <input type="checkbox"/> IF TELESCOPED OR MORE THAN ONE SCREEN, USE BACK PAGE

DESCRIPTION OF FORMATIONS ENCOUNTERED	FROM	TO	FORMATIONS (Continued)	FROM	TO
<b>CLAY</b>	<b>0</b>	<b>12</b>	Dept. of Environmental Quality Office of Land & Water Resources JUDGES		
<b>CLAY &amp; SAND ledges</b>	<b>12</b>	<b>261</b>			
<b>CLAY</b>	<b>261</b>	<b>290</b>			
<b>SAND</b>	<b>290</b>	<b>330</b>			

IF MORE SPACE IS NEEDED, USE BACK

If well telescopes please  
sketch and show depths.

GROUND LEVEL

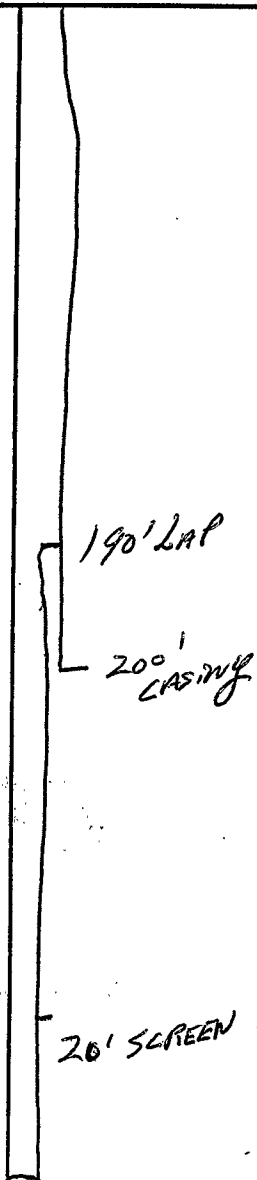

	X		

SECTION 9

Please indicate well location X.

ADDITIONAL INFORMATION

---

---

If more than one screen,