

Scott
3 H I
3-67

MISSISSIPPI
BOARD OF WATER COMMISSIONERS
416 North State Street
Jackson, Mississippi 39201

WATER WELL DRILLERS LOG

3-21 1967 date well completed
Wilkinson Drilling Service firm name
Scott county well located

LANDOWNER: Hunter P. Smyth

description of formations encountered	from	to
Clay - yellow	0	20
Blue Shale	20	30
Sand	30	50
Brown Shale	50	120
Sand Water	120	174


Forest MISS (mailing address)

WELL LOCATION:
sec. 34 T. 14 N. R. 9 E. S. 9 W.
6 miles NE of Forest
(distance) (direction) (nearest town)

WELL PURPOSE: home
(home, irrigation, municipal, industrial)

WELL COMPLETION DATA:

- (1) diameter (inches) 2"
- (2) total depth (feet) 174
- (3) static water level (feet) 55 ^{below} _{above} top of ground.
- (4) casing 2" Galv. 168' (material) (depth)
2" ~~Galv~~ if telescope see back. (size)
- (5) screen 6' 174' (length) (depth to top)
10610f (size) Brass (material)
- (6) pump 2 (HP) 1100 gpm (yield gpm)
Elec (type power)
- (7) electric log NO (yes or no)
(organization running log)
- (8) how well bottom plugged BWV

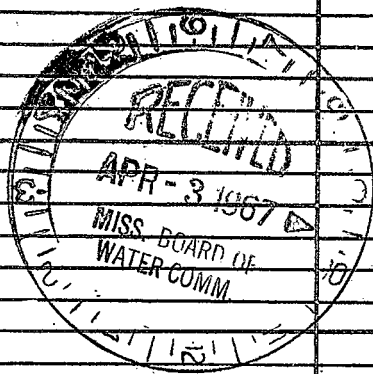

DRILLERS REMARKS:

If well telescopes please sketch and show depths.

GROUND LEVEL

			X
		24 20	

SECTION 34

Please indicate well location X.

ADDITIONAL INFORMATION

If more than one screen, show locations of each on sketch.