

SCOTT

MISSISSIPPI BOARD OF WATER COMMISSIONERS

WATER WELL DRILLERS LOG

4  
6-12-63

Date: 6-12, 1963, Driller: Comant County: Scott  
(Name)

(1) Owner of Land: Dallas Edwards  
(Name)  
Comatta  
(Address)

(2) Location: 1/4, 1/4, Sec. 36 T. 7 R. 9,  
\_\_\_\_\_ miles \_\_\_\_\_ of \_\_\_\_\_  
(distance) (direction) (Nearest Town)

(3) Topography: X  
(Hilly) (Flat) (Level)

(4) Purpose of Well: D  
(Domestic Irrigation  
Municipal, Industrial, Other)

Description & Color of Materials Sand, Clay, Red Clay, Shell, etc.	Thick- ness Feet	Depth Feet
<del>255</del>		
Sandy Clay	0	75
SPHATE SAND	75	200
Rock + Sand		
Sand	200	228
Light Clay	228	300
Shell + Rock		
Ledges	300	320
Winona Sand	320	350
Rock Ledges + Light		
gray clay layers	350	380

Information upon completion of well:

(1) Diameter 2 inches.

(2) Total Depth 380 feet.


(3) Water Level 425 feet below top of ground.

(4) Cased to 231, Size 2

(5) Screen: Size \_\_\_\_\_, Length \_\_\_\_\_

(6) Were any formations sealed against pollution?  
\_\_\_\_\_ yes, X no.

Water was most  
predominant  
in rock ledges  
below sand  
2254

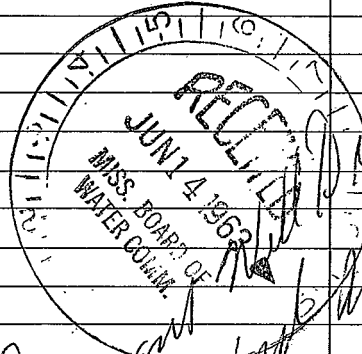

If YES depth of formation \_\_\_\_\_  
Why \_\_\_\_\_

Drillers Remarks: open well  
in Winona Sand  
1 HP Stalite  
Pump BA jet - set 105 ft

(Use Back Side)

Well No.

