

SCOTT MISSISSIPPI BOARD OF WATER COMMISSIONERS

WATER WELL DRILLERS LOG

Date: 9/8, 1962, Driller: Forest Drilling Co. County: Scott.  
 (Name)


(1) Owner of Land: R. O. ADCox  
 (Name)  
Rt 3 Forest, Miss  
 (Address)  
 (2) Location: 1/4, 1/4, Sec. 34 T. R  
7 miles North East of Forest  
 (distance) (direction) (Nearest Town)  
 (3) Topography: X  
 (Hilly) (Flat) (Level)  
 (4) Purpose of Well: Chickens  
 (Domestic Irrigation, Municipal, Industrial, Other)

Description & Color of Materials Sand, Clay, Red Clay, Shell, etc.	Thick- ness Feet	Depth Feet
Clay	0	62
Clay & Muddy sand		82
Fine sand & silty clay		116
Clay		132
Clay & silty sand		192
Clay		198
Fine sand & silty clay		212
Fine sand		218
Clay		222
Fine sand		242

Information upon completion of well:

(1) Diameter 2" inches.  
 (2) Total Depth 241 feet.  
 (3) Water Level 30ft. feet below top of ground.  
 (4) Cased to 231", Size 2"  
 (5) Screen: Size 2inch, Length 10ft.  
 (6) Were any formations sealed against pollution?  
 \_\_\_\_\_ yes, X no.

If YES depth of formation \_\_\_\_\_  
 Why \_\_\_\_\_  
 Drillers Remarks: \_\_\_\_\_

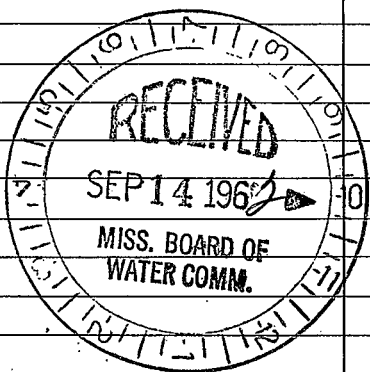

(Use Back Side)

Well No.

