

SCOTT MISSISSIPPI BOARD OF WATER COMMISSIONERS

H4 T  
9-12-62

WATER WELL DRILLERS LOG

Date: 9-12, 1962, Drillers: Forest Drilling Co County Scott  
(Name)

(1) Owner of Land: Inmy Bell  
(Name)  
Hillsboro, Miss.  
(Address)

(2) Location: 1/4, 1/4, Sec. 34 T. 10 R. 10  
7 miles North East of Forest  
(distance) (direction) (Nearest Town)

(3) Topography: X  
(Hilly) (Flat) (Level)

(4) Purpose of Well: Children  
(Domestic Irrigation  
Municipal, Industrial, Other)

Description & Color of Materials Sand, Clay, Red Clay, Shell, etc.	Thick- ness Feet	Depth Feet
<u>Clay</u>	<u>0</u>	<u>42</u>
<u>Clay &amp; sh. mpy sand</u>		<u>72</u>
<u>Clay &amp; sh. Fin Sand</u>		<u>92</u>
<u>Sh. sand &amp; sh. Clay</u>		<u>116</u>
<u>Clay</u>		<u>127</u>
<u>Clay &amp; sh. sand</u>		<u>172</u>
<u>Fine Sand</u>		<u>196</u>
<u>Fine Sand &amp; sh. Clay</u>		<u>212</u>
<u>Fine Sand</u>		<u>232</u>
<u>Good Sand</u>		<u>241</u>

Information upon completion of well:

(1) Diameter 2" inches.

(2) Total Depth 241 feet.

(3) Water Level 30 ft feet below top of ground.

(4) Cased to 231, Size 2"


(5) Screen: Size 2", Length 10 ft

(6) Were any formations sealed against pollution?  
\_\_\_\_\_ yes, X no.

If YES depth of formation \_\_\_\_\_

Why \_\_\_\_\_

Drillers Remarks: \_\_\_\_\_

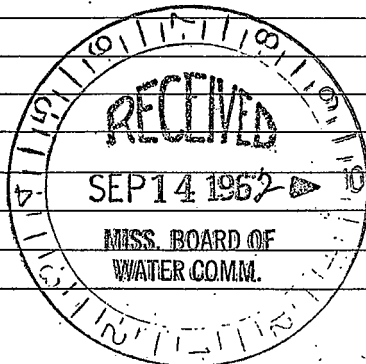

(Use Back Side)

Well No.

