

SCOTT MISSISSIPPI BOARD OF WATER COMMISSIONERS

H5  
6-25-63

WATER WELL DRILLERS LOG

Date: 6/25, 1963, Driller: Frank Dalgard County: Scott  
(Name)

(1) Owner of Land: Fred Gaddis  
(Name)  
Frank Miss!  
(Address)

(2) Location: 1/4, 1/4, Sec. 11 T. R  
8 miles Northwest of Frank  
(distance) (direction) (Nearest Town)

(3) Topography: X  
(Hilly) (Flat) (Level)

(4) Purpose of Well: Children  
(Domestic Irrigation  
Municipal, Industrial, Other)

Description & Color of Materials Sand, Clay, Red Clay, Shell, etc.	Thick- ness Feet	Depth Feet
Clay	0	6
Clay & Rock		18
Sand		84
Clay		112
Sandy Shell Rock		122
Clay & Shells Rock		132
Shale		160
Rock		163
Shells		172
Clay & Sandy Shell		182
Clay		202
Clay & Shells		212
Shells Sand		237
Fine Sand		242
Fine Sand & Sh. clay		272
Fine Sand		282
Fine Sand & Clay		302
Fine Sand		346
Good Sand		330

Information upon completion of well:

(1) Diameter 2" inches.

(2) Total Depth 330 feet.

(3) Water Level 80 feet below top of ground.

(4) Cased to 215, Size 2"


(5) Screen: Size 2", Length 15ft.

(6) Were any formations sealed against pollution?  
\_\_\_\_\_ yes, X no.

If YES depth of formation \_\_\_\_\_

Why \_\_\_\_\_

Drillers Remarks: \_\_\_\_\_

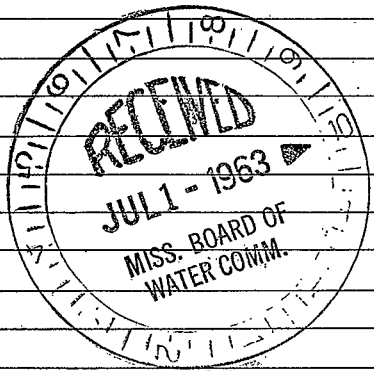

(Use Back Side)

Well No.

