

H. C.
7-29-64

WATER WELL DRILLERS LOG

Date: 7/29, 1964, Driller: Furst Drilling County, Scott
(Name)


(1) Owner of Land: <u>Jeff Acemmers</u> (Name)	Description & Color of Materials Sand, Clay, Red Clay, Shell, etc.	Thick- ness Feet	Depth Feet
<u>Rt one Furst Miss.</u> (Address)	<u>Red Sand</u>	<u>0</u>	<u>36</u>
(2) Location: <u>1/4</u> , <u>1/4</u> , Sec. <u>26</u> T. <u>1</u> R. <u>1</u>	<u>Clay</u>		<u>52</u>
<u>8</u> miles <u>N. E.</u> of <u>Furst</u> (distance) (direction) (Nearest Town)	<u>Clay & Rock</u>		<u>62</u>
(3) Topography: <input checked="" type="checkbox"/> (Hilly) <input type="checkbox"/> (Flat) <input type="checkbox"/> (Level)	<u>Clay</u>		<u>98</u>
(4) Purpose of Well: <u>Home</u> (Domestic Irrigation Municipal, Industrial, Other)	<u>Rock</u>		<u>102</u>
	<u>Clay</u>		<u>114</u>
	<u>Fine Sand</u>		<u>122</u>
	<u>Fine Sand + Shls Clay</u>		<u>132</u>
	<u>Fine Sand</u>		<u>140</u>
	<u>Fine Sand + Shls Clay</u>		<u>146</u>
	<u>Fine Sand</u>		<u>154</u>
			<u>15</u>

Information upon completion of well:

- (1) Diameter 2 inches.
- (2) Total Depth 154 feet.
- (3) Water Level 94 feet below top of ground.
- (4) Cased to 144, Size 2"
- (5) Screen: Size 2", Length 10ft.
- (6) Were any formations sealed against pollution?
 yes, no.

If YES depth of formation _____
Why _____

Drillers Remarks: _____

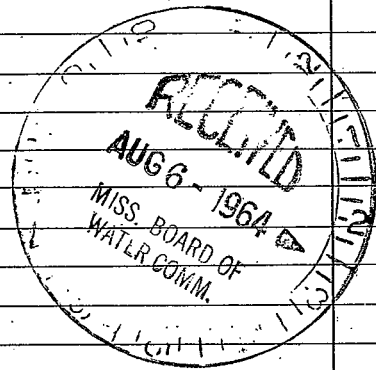

(Use Back Side)

Well No.

