

SCOTT 7

H 7 MISSISSIPPI BOARD OF WATER COMMISSIONERS

7-20-65

WATER WELL DRILLERS LOG

Date: 7-20, 1965, Driller: LEACH County: Scott
(When well drilled) (Name) (Where well is located)


(1) Owner of Land: Homer Putnam
(Name)
Rt 4 Forest Miss.
(Address)
(2) Location: 1/4, 1/4, Sec. 14 T. R.
10 miles N-East, of Forest
(distance) (direction) (Nearest Town)
(3) Topography: (Hilly) (Flat) (Level)
(4) Purpose of Well: (Domestic Irrigation) (Municipal, Industrial, Other)

Description & Color of Materials Sand, Clay, Red Clay, Shell, etc.	Thick- ness Feet	Depth Feet
Clay	20	20
Sand	20	40
Rock + Sand	35	75
Older Clay	55	130
Sandy clay	10	140
Sand	15	215

Information upon completion of well:

(1) Diameter 2 inches.
(2) Total Depth 215 feet.
(3) Water Level 90 feet below top of ground.
(4) Cased to 210, Size 2"
(5) Screen: Size 2, Length 5'
(6) Were any formations sealed against pollution?
yes, no.

If YES depth of formation
Why
Drillers Remarks:
Yield in gpm: 12
Size pump: 1 1/2 in
Type power:

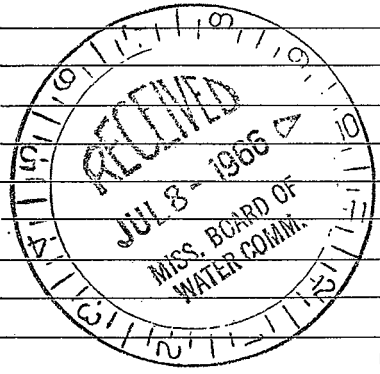

215

