

SCOTT T

MISSISSIPPI BOARD OF WATER COMMISSIONERS

3

1-10-66

WATER WELL DRILLERS LOG

LEACH

Date: 7-10, 1966, Driller: J Thom County: SCOTT

(1) Owner of Land: Met Williams

RX1 LAKE

(2) Location: 1/4, 1/4, Sec 18 T R

10 miles N-West of Lake

(3) Topography: (Hilly) (Flat) (Level)

(4) Purpose of Well: (Domestic Irrigation) (Municipal, Industrial, Other)

Description & Color of Materials Sand, Clay, Red Clay, Shell, etc.	Thick- ness Feet	Depth Feet
Sand	20	20
gravel	30	50
Rock	42	92
Blue clay	90	182
Sand & clay	35	217
Sand	77	294

Information upon completion of well:

(1) Diameter 2 inches.

(2) Total Depth 294 feet.

(3) Water Level 150 feet below top of ground.

(4) Cased to 289, Size 2"

(5) Screen: Size 2, Length 5

(6) Were any formations sealed against pollution? yes, no.

If YES depth of formation


Why

Drillers Remarks:

Yield in gpm: 10

Size pump: 2 HP

Type power:

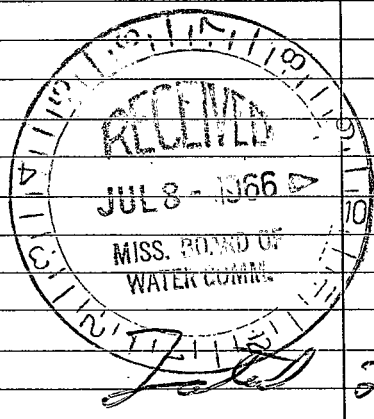

Total 294

