

SCOTT

H 11

T

WATER WELL DRILLERS LOG

5-14-66

Date: May 14, 1966, Driller: Roy Wilkinson County Scott

(Name)

(1) Owner of Land: Homer Gibson
(Name)

Conehatta, Miss
(Address)

(2) Location: 1/4, 1/4, Sec. 24 ^{711 95} T R

3.5 miles S.W., of Conehatta
(distance) (direction) (Nearest Town)

(3) Topography: Hilly
(Hilly) (Flat) (Level)

(4) Purpose of Well: Domestic
(Domestic Irrigation
Municipal, Industrial, Other)

Description & Color of Materials Sand, Clay, Red Clay, Shell, etc.	Thick- ness Feet	Depth Feet
<u>Top Stratum Soil</u>	<u>30</u>	
<u>Red Saddy Clay</u>	<u>103</u>	
<u>Rocky (Lumpy)</u>	<u>50</u>	
<u>Water B. Sand</u>	<u>35</u>	

Information upon completion of well:

(1) Diameter 2 inches.

(2) Total Depth 218 feet.

(3) Water Level 78 feet below top of ground.

(4) Cased to 218', Size 2"


(5) Screen: Size 2", Length 6'

(6) Were any formations sealed against pollution?
_____ yes, _____ no.

If YES depth of formation _____

Why _____

Drillers Remarks: _____

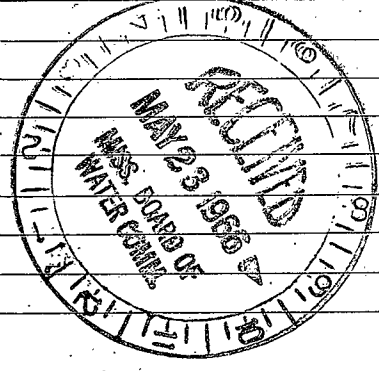

(Use Back Side)

Well No.

