

SCOTT

MISSISSIPPI

WELL DRILLERS

WATER WELL DRILLERS LOG

Date: 3-27, 1963, Driller: Ray Cox County Scott

(1) Owner of Land: James L. Parker
(Name)
Conehatta RT # 2
(Address)

(2) Location: 1/4, 1/4, Sec 24 T 7 R 9
3 miles S of Conehatta
(distance) (direction) (Nearest Town)

(3) Topography: X
(Hilly) (Flat) (Level)

(4) Purpose of Well:
(Domestic Irrigation
Municipal, Industrial, Other)

Description & Color of Materials Sand, Clay, Red Clay, Shell, etc.	Thick- ness Feet	Depth Feet
<u>0 to 15' Red Clay</u>		
<u>15 to 20' Red Sand</u>		
<u>20 to 40' White + gray Chalk</u>		
<u>40 to 50' Shell + Sand</u>		
<u>50 - 80' Brown Chalk</u>		
<u>80 - 100' Shell, rock + sand</u>		
<u>110 - 145' Brown Chalk</u>		
<u>145 - 155' Shell + gray sand</u>		
<u>155 - 195' Green + Brown Chalk</u>		
<u>195 - 210' Light Gray Sand</u>		

Information upon completion of well:

(1) Diameter 2" inches.

(2) Total Depth 210 feet.

(3) Water Level 88 feet below top of ground.

(4) Cased to 116', Size 2"

(5) Screen: Size None, Length _____
Open bottom well


(6) Were any formations sealed against pollution?
_____ yes, _____ no.

If YES depth of formation _____

Why _____

Drillers Remarks: _____

Common Well Drilling
Company
Subsidiary of

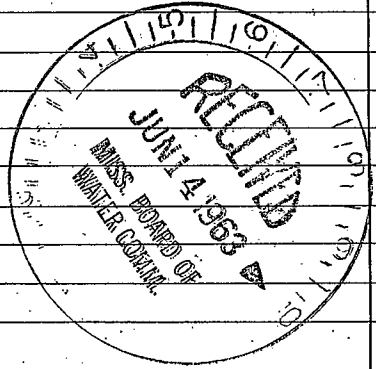

(Use Back Side)

Well No.

