

SCOTT MISSISSIPPI BOARD OF WATER COMMISSIONERS

T
WATER WELL DRILLERS LOG

4 M H 13
11-6-62
Date: 11-6, 1962, Driller: Leach County Scott
(Name)


(1) Owner of Land: Jerry Judge
(Name)
Lake Miss.
(Address)
(2) Location: 1/4, 1/4, Sec. 27 T. R.
5 miles NW, of Lake
(distance) (direction) (Nearest Town)
(3) Topography: Flat
(Hilly) (Flat) (Level)
(4) Purpose of Well: Domestic
(Domestic Irrigation
Municipal, Industrial, Other)

Description & Color of Materials Sand, Clay, Red Clay, Shell, etc.	Thick- ness Feet	Depth Feet
<u>Red clay</u>	<u>15'</u>	
<u>Blue clay</u>	<u>30</u>	<u>45</u>
<u>Sand & clay</u>	<u>20</u>	<u>65</u>
<u>Sand</u>	<u>67</u>	<u>132</u>

Information upon completion of well:

(1) Diameter 2 inches.
(2) Total Depth 132 feet.
(3) Water Level 30 feet below top of ground.
(4) Cased to 132 ft., Size 2"
(5) Screen: Size 2", Length 6'
(6) Were any formations sealed against pollution?
_____ yes, no no.

If YES depth of formation _____
Why _____
Drillers Remarks: _____

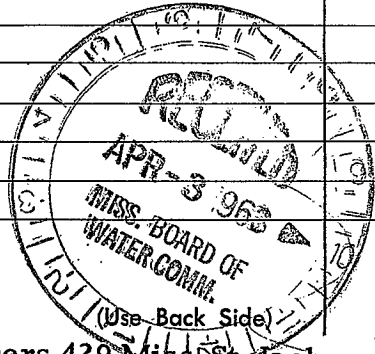

Well No.

[The page contains extremely faint and illegible text, likely bleed-through from the reverse side of the document. No specific words or phrases can be discerned.]