

NEWTON Scott?

J
12-10-64

MISSISSIPPI BOARD OF WATER COMMISSIONERS

WATER WELL DRILLERS LOG

Date: 12-10, 1964 Driller: LEACH County: Newton
(When well drilled) (Name) (Where well is located)

(1) Owner of Land: Herman Gibbs
(Name)

RT 1 Lake Miss
(Address)

(2) Location: 1/4, 1/4, Sec. 25 10 9C T. R

5 miles North of Lake
(distance) (direction) (Nearest Town)

(3) Topography: (Hilly) (Flat) (Level)

(4) Purpose of Well: (Domestic Irrigation) (Municipal, Industrial, Other)

Description & Color of Materials Sand, Clay, Red Clay, Shell, etc.	Thick- ness Feet	Depth Feet
<u>Red clay</u>	<u>30</u>	<u>30</u>
<u>sand</u>	<u>10</u>	<u>40</u>
<u>Rock</u>	<u>20</u>	<u>60</u>
<u>sand shell</u>	<u>10</u>	<u>70</u>
<u>sand</u>	<u>14</u>	<u>84</u>

Information upon completion of well:

(1) Diameter 2 inches.

(2) Total Depth 84 feet.

(3) Water Level 60 feet below top of ground.

(4) Cased to 79, Size 2"

(5) Screen: Size 2, Length 5'

(6) Were any formations sealed against pollution?
no

If YES depth of formation _____


Why _____

Drillers Remarks: _____

Yield in gpm: 6

Size pump: 1 1/2

Type power: _____

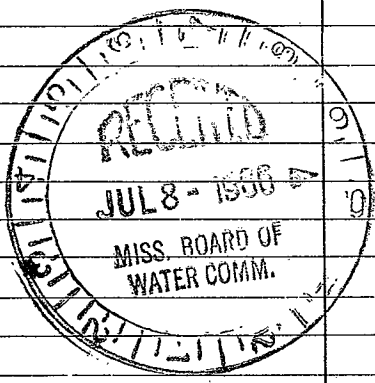

Total 84

