

NEWTON

MISSISSIPPI BOARD OF WATER COMMISSIONERS

3-30-65

6 H I S T

WATER WELL DRILLERS LOG


Date: 3-30, 1965, Driller: J. Horn, County: Newton

(1) Owner of Land: Harry Thompson
RT 1 Lake Miss.
(2) Location: 1/4, 1/4, Sec. 25 T. R.
5 miles north of lake
(3) Topography: Flat
(4) Purpose of Well: Domestic Irrigation

Table with 3 columns: Description & Color of Materials, Thickness Feet, Depth Feet. Rows include: Red clay, Sand, Blue clay, Sand & Rock, Sand.

Information upon completion of well:

(1) Diameter 2 inches.
(2) Total Depth 110 feet.
(3) Water Level 50 feet below top of ground.
(4) Cased to 105, Size 2"
(5) Screen: Size 2, Length 3'
(6) Were any formations sealed against pollution? no.

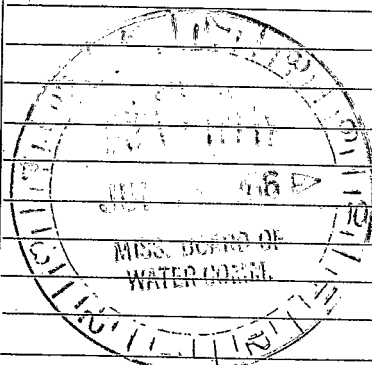

If YES depth of formation
Why
Drillers Remarks:
Yield in gpm: 20
Size pump: 1 1/2 in.
Type power:

Retain this copy for your office files.

1911

1911