

NEWTON

8-31-60

WATER WELL DRILLERS LOG

Owned this by Scott Co.

Scott

Date: 8/31, 1960, Driller: James McGee County Newton

(Name)

(1) Owner of Land: Marvin Gibbs (Name) Lawrence, Miss. (Address) (2) Location: 1/4, 1/4, Sec. 25 7th 12th T R 6 miles North of Lake (distance) (direction) (Nearest Town) (3) Topography: X (Hilly) (Flat) (Level) (4) Purpose of Well: Domestic (Domestic Irrigation Municipal, Industrial, Other)

Table with 3 columns: Description & Color of Materials, Thickness Feet, Depth Feet. Contains entries for Clay (0' 17') and Sand (17' 68').


Information upon completion of well:

(1) Diameter 2" inches. (2) Total Depth 68' feet. (3) Water Level 24 feet below top of ground. (4) Cased to 63', Size 2" (5) Screen: Size 2", Length 5' (6) Were any formations sealed against pollution? yes, X no.

If YES depth of formation

Why

Drillers Remarks: Good well.

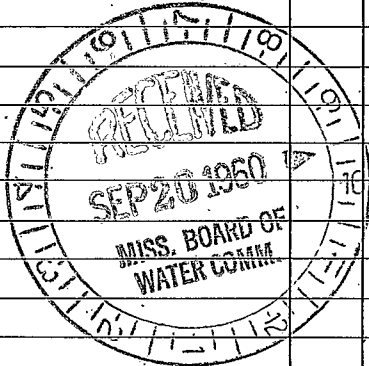

Well No.

(Use Back Side)

