

NEWTON *sett*

J

4-19-66

MISSISSIPPI BOARD OF WATER COMMISSIONERS

WATER WELL DRILLERS LOG

6H18

Date: 4 19, 1966, Driller: LEACH County Newton
(When well drilled) (Name) (Where well is located)

(1) Owner of Land: Orvin Cooney
(Name)
RAL LAKE MISS
(Address)

(2) Location: $\frac{1}{4}$, $\frac{1}{4}$, Sec. 35 T. 7N R. 9E
4 miles north of Lake
(distance) (direction) (Nearest Town)

(3) Topography: (Hilly) (Flat) (Level)

(4) Purpose of Well: (Domestic Irrigation) (Municipal, Industrial, Other)

Description & Color of Materials Sand, Clay, Red Clay, Shell, etc.	Thick- ness Feet	Depth Feet
<u>red clay</u>	<u>20</u>	<u>20</u>
<u>sand</u>	<u>10</u>	<u>30</u>
<u>blue clay</u>	<u>20</u>	<u>50</u>
<u>sandy clay</u>	<u>45</u>	<u>95</u>
<u>sand</u>	<u>20</u>	<u>115</u>

Information upon completion of well:

(1) Diameter 2 inches.


(2) Total Depth 115 feet.

(3) Water Level 18 feet below top of ground.

(4) Cased to 110, Size 2"

(5) Screen: Size 2", Length 5'

(6) Were any formations sealed against pollution?
no

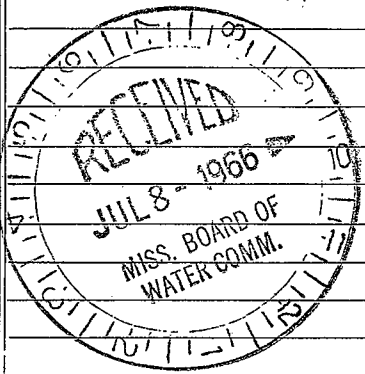

If YES depth of formation _____

Why _____

Drillers Remarks: _____

Yield in gpm: 20

Size pump: 1 HP.

Type power: _____

Total 115

