

NEWTON

MISSISSIPPI BOARD OF WATER COMMISSIONERS

6 H19

T

WATER WELL DRILLERS LOG

SCOTT

Date: 2-5-63, 1963, Driller: LEACH

County: ALBANY

(Name)

(1) Owner of Land: m. T. Chell (Name)

LAKE MISS. (Address)

(2) Location: 1/4, 1/4, Sec 35 T. R.

4 miles north of LAKE (distance) (direction) (Nearest Town)

(3) Topography: (Hilly) (Flat) (Level)

(4) Purpose of Well: DOMESTIC (Domestic Irrigation, Municipal, Industrial, Other)

Information upon completion of well:

(1) Diameter 2 inches.

(2) Total Depth 121 feet.

(3) Water Level 20 feet below top of ground.

(4) Cased to 121, Size 2

(5) Screen: Size 2, Length 6

(6) Were any formations sealed against pollution? yes, no.

If YES depth of formation

Why


Drillers Remarks:

Description & Color of Materials Sand, Clay, Red Clay, Shell, etc.

Thickness Feet

Depth Feet

sand & clay 30 50
blue clay 30 70
sand 5 121

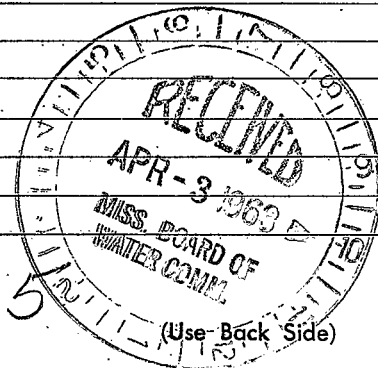

Well No.

Retain this copy for your office files.

WATER WELL DRILLERS LOG

Date: _____, 19____, Driller: _____ County _____
(Name)

	Description & Color of Materials Sand, Clay, Red Clay, Shell, etc.	Thick- ness Feet	Depth Feet
(1) Owner of Land: _____ <small>(Name)</small>			
_____ <small>(Address)</small>			
(2) Location: _____ ¼, _____ ¼, Sec. _____ T _____ R _____, _____ miles _____ of _____ <small>(distance) (direction) (Nearest Town)</small>			
(3) Topography: _____ <small>(Hilly) (Flat) (Level)</small>			
(4) Purpose of Well: _____ <small>(Domestic Irrigation, Municipal, Industrial, Other)</small>			
Information upon completion of well:			
(1) Diameter _____ inches.			
(2) Total Depth _____ feet.			
(3) Water Level _____ feet below top of ground.			
(4) Cased to _____, Size _____.			
(5) Screen: Size _____, Length _____.			
(6) Were any formations sealed against pollution? _____ yes, _____ no.			
If YES depth of formation _____.			
Why _____.			
Drillers Remarks: _____			

_____			Well No.

(Use Back Side)

Retain this copy for your office files.