

Scott  
H 20  
12-67

MISSISSIPPI  
BOARD OF WATER COMMISSIONERS  
416 North State Street  
Jackson, Mississippi 39201

WATER WELL DRILLERS LOG

12-1 date well completed 1977 COMANS DRILLING CORP firm name Scott county well located

LANDOWNER: Will Dickson  
R#1 Forest Miss  
(mailing address)

description of formations encountered	from	to
Clay	0	112
FINE SAND	112	149
Clay	149	328
SAND	328	367

WELL LOCATION:  
sec 7 T 2 N R 9 E  
S W  
11 miles S of Sebastopol  
(distance) (direction) (nearest town)

WELL PURPOSE: HOME  
(home, irrigation, municipal, industrial)


- WELL COMPLETION DATA:
- (1) diameter (inches) 2
  - (2) total depth (feet) 363
  - (3) static water level (feet) 90 below above top of ground.
  - (4) casing 2 (material), (depth), (size) if telescope see back.
  - (5) screen (length), (depth to top), (size), (material)
  - (6) pump (HP), (yield gpm), (type power)
  - (7) electric log (yes or no), (organization running log)
  - (8) how well bottom plugged

DRILLERS REMARKS:

JUN-5 1978  
MISS. BOARD OF  
WATER COM.

If well telescopes please sketch and show depths.

GROUND LEVEL

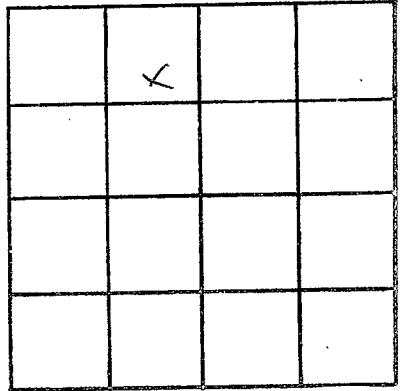

SECTION 7

Please indicate well location X.

ADDITIONAL INFORMATION

If more than one screen, show locations of each on sketch.