

SCOTT
 HZ1 CODED
 8-6-60
 CODED

WATER WELL DRILLERS LOG

MT olew

Date: 8/6, 1960, Driller: Johnnie Beasley County Scott.

(Name)

- (1) Owner of Land: Scott Co. Schools
 (Name)
Forest, Miss.
 (Address)
- (2) Location: NW 1/4, NW 1/4, Sec. 34 7N 9E
 (distance) (direction) (Nearest Town)
- (3) Topography: X
 (Hilly) (Flat) (Level)
- (4) Purpose of Well: Colored School
 (Domestic Irrigation
 Municipal, Industrial, Other)

Description & Color of Materials Sand, Clay, Red Clay, Shell, etc.	Thick- ness Feet	Depth Feet
Red Clay.	0	16
Blue Clay.	16	36
Clay & Stks. Silt Sand.	36	61
Sand & Stks. Clay.	61	81
Fine Sand.	81	102
Fine Sand & Stks. Clay	102	113
Red Sand & Stks. Clay	113	143
Fine Sand & Stks. Clay	143	164
Hard Blue Shale & Stks.		
Rock.	164	184
Hard Shale.	184	225
Shale. ^{4"} casing set to this depth.	225	254
Shale & Rock.	254	266
Shale & Shell.	266	275
Fine Sand. (10' Screen Set here)	275	285
Fine Sand. (10' 2" Screen Set Here)	285	295
Mucky Sand.	295	303
Fine Sand. (25' 2" Screen Set Here)	303	328
Shale.	328	349


Information upon completion of well:

- (1) Diameter 4X2 1/2 inches.
- (2) Total Depth 348 feet.
- (3) Water Level 135 feet below top of ground.
- (4) Cased to 45', Size 4" & 2 1/2"
- (5) Screen: Size 2" & 2 1/2" Length 45'
- (6) Were any formations sealed against pollution?
yes, X no.

If YES depth of formation _____
 Why _____

Drillers Remarks: Good well

CODED

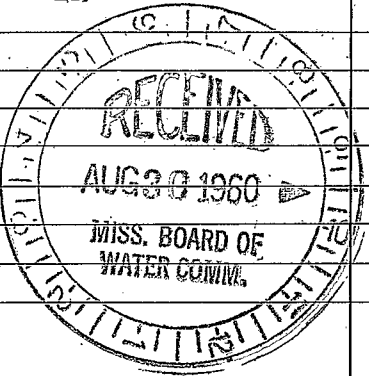

(Use Back Side)

Well No.

