

CODED

MISSISSIPPI  
BOARD OF WATER COMMISSIONERS  
416 North State Street  
Jackson, Mississippi 39201

WATER WELL DRILLERS LOG

Scott  
H22  
10-69

oct 1969 Will Kearsal Drilling Scott  
date well completed firm name county well located

LANDOWNER:  
Mr EARL Posey  
LAKE MISS  
(mailing address)

description of formations encountered	from	to
clay		20
clay - sand	20	88

WELL LOCATION:  
sec. 26 T 7 N R 9 E  
S W  
6 miles NW of LAKE  
(distance) (direction) (nearest town)

WELL PURPOSE: home  
(home, irrigation, municipal, industrial)


- WELL COMPLETION DATA:
- (1) diameter (inches) 2
  - (2) total depth (feet) 88
  - (3) static water level (feet) 21 <sup>below</sup>/<sub>above</sub> top of ground.
  - (4) casing GALV, 84, (material) (depth)  
if telescope see back. (size)
  - (5) screen 4, 88 (length) (depth to top)  
2, STANLIS (size) (material)
  - (6) pump 1 1/2, 11 (HP) (yield gpm)  
E/K/S (type power)
  - (7) electric log NO (yes or no)  
(organization running log)
  - (8) how well bottom plugged 2 BALL

DRILLERS REMARKS:

NOV 27 1969  
MISSISSIPPI  
WATER BOARD

If well telescopes please sketch and show depths.

GROUND LEVEL

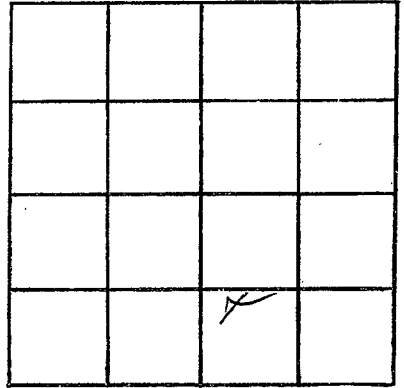

SECTION 26

Please indicate well location X.

ADDITIONAL INFORMATION

If more than one screen,  
show locations of each on sketch.