

CODED

MISSISSIPPI
BOARD OF WATER COMMISSIONERS
416 North State Street
Jackson, Mississippi 39201

WATER WELL DRILLERS LOG

Scott
H23
10-69

Oct 19 Wilkinson Driller Scott
date well completed firm name county well located

LANDOWNER:

Mr Turnage

LAK - MISS
(mailing address)

description of formations encountered

from

to

Clay 0 140
SAND + CLAY 40 100
SAND 60 135

WELL LOCATION:

sec 27 T 7 N R 9 E
S W
6 miles NW of Lake
(distance) (direction) (nearest town)

WELL PURPOSE: dom
(home, irrigation, municipal, industrial)

WELL COMPLETION DATA:

- (1) diameter (inches) 2
- (2) total depth (feet) 135
- (3) static water level (feet) 50 ^{below}/_{above} top of ground.
- (4) casing Galv,
(material) (depth)
 if telescope see back.
(size)
- (5) screen 5, 131
(length) (depth to top)
2, Stainless
(size) (material)
- (6) pump 1 1/2 10
(HP) (yield gpm)
Elec
(type power)
- (7) electric log No
(yes or no)

(organization running log)
- (8) how well bottom plugged 2" BWC


DRILLERS REMARKS:

OCT 27 1969

MISS. Bd. of WATER COMMISSIONERS

If well telescopes please sketch and show depths.

GROUND LEVEL

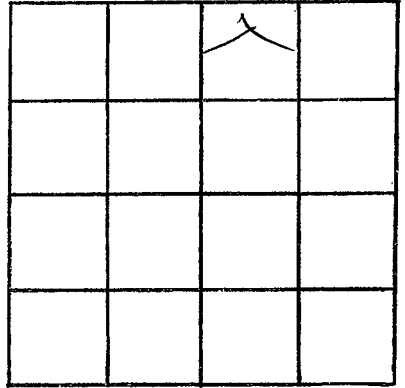

SECTION *27*

Please indicate well location X.

ADDITIONAL INFORMATION

If more than one screen,
show locations of each on sketch.