

SCOTT
H 25
12-28-72

MISSISSIPPI
 BOARD OF WATER COMMISSIONERS
 416 North State Street
 Jackson, Mississippi 39201

WATER WELL DRILLERS LOG

CODED

J.D. Connors SCOTT

12/28/72 19__
 date well completed

firm name

county well located

LANDOWNER: Donald M. ...

Description of formations encountered

from to

<u>Red clay</u>	<u>0</u>	<u>20</u>
<u>Chert</u>	<u>20</u>	<u>40</u>
<u>Sand chert</u>	<u>40</u>	<u>65</u>

(mailing address)

WELL LOCATION:

sec 29 07 0 @ 9 0
5 1/2 miles S of Forest
 (distance) (direction) (nearest town)

WELL PURPOSE:

(home) irrigation, municipal, industrial

WELL COMPLETION DATA:

- (1) diameter (inches) 2 1/2
- (2) total depth (feet) 65
- (3) static water level (feet) 30 below above top of ground.
- (4) casing 2 1/2" PVC (material) 59' (depth)
- (5) screen 2 1/2" (length) 45' (depth to top)
- (6) pump 1/2 (HP) 110 (yield gpm)
- (7) electric log Electric (type power)
- (7) electric log no (yes or no)

CODED

(organization running log)


(8) how well bottom plugged any

DRILLERS REMARKS:

JAN 4 1973

If well telescopes please sketch and show depths.

GROUND LEVEL

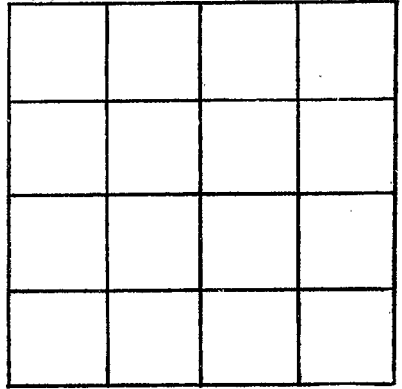

SECTION _____

Please indicate well location X.

ADDITIONAL INFORMATION

If more than one screen, show locations of each on sketch.