

SCOTT  
H 26  
12/78

MISSISSIPPI  
BOARD OF WATER COMMISSIONERS  
416 North State Street  
Jackson, Mississippi 39201

CODED

WATER WELL DRILLERS LOG

date well completed Dec 19 78 W. W. Benson firm name Scott county well located

LANDOWNER: J. B. Wolf  
Lake, Miss.  
(mailing address)

description of formations encountered	from	to
<u>Clay</u>	<u>0</u>	<u>06</u>
<u>Sand</u>	<u>6</u>	<u>85</u>
<u>Clay</u>	<u>85</u>	<u>210</u>
<u>Broken Clay</u>	<u>210</u>	<u>220</u>
<u>Sand</u>	<u>220</u>	<u>257</u>

WELL LOCATION:  
sec. 32 T. 7 N. R. 9 E  
6 miles N of Lake  
(distance) (direction) (nearest town)

WELL PURPOSE: Home  
(home, irrigation, municipal, industrial)

WELL COMPLETION DATA:

(1) diameter (inches) 2"

(2) total depth (feet) 257

(3) static water level (feet) 90' below top of ground.

(4) casing well (material) 252 (depth)

         If telescope see back.  
(size)

(5) screen 5' (length) 252' (depth to top)

2" (size) 8 (material) Steel

(6) pump 2H (HP) 10 (yield gpm)

elec (type power)

(7) electric log no (yes or no)

         (organization running log)

(8) how well bottom plugged 2" B. W. D.

CODED


RECEIVED  
JAN 28 1978

DRILLERS REMARKS:

MISSISSIPPI BOARD OF WATER COMMISSIONERS

If well telescopes please sketch and show depths.

GROUND LEVEL

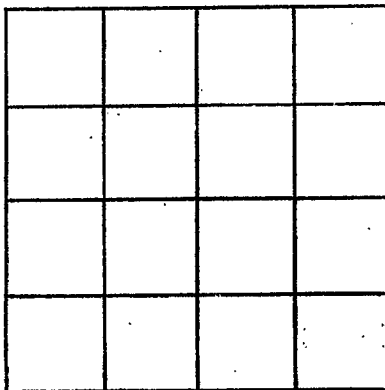

SECTION \_\_\_\_\_

Please indicate well location X.

ADDITIONAL INFORMATION

If more than one screen, show locations of each on sketch.